IREDELL COUNTY HEALTH DEPARTMENT

STATESVILLE 704-878-5305 MOORESVILLE 704-664-5281

IMPROVEMENT PERMIT / AUTHORIZATION TO CONSTRUCT / OPERATION PERMIT / EXISTING SYSTEM INSPECTION

PERMIT# 138914 PIN# 4676866806 DATE 11-7-06

OWNER OR APPLICANT Jacob Compton PHONE: Business _____ Home 704-663-3650

ADDRESS 441 Teeter Rd Mooresville 28115

LOCATION 115 N TR main TR Linwood TL Teeter on right across from 456 Teeter

SUBDIVISION _____ BLOCK / SECTION _____ LOT _____ LOT AREA .656 Ac SITE CLASS PS DESIGN FLOW 360gpd L.T.A.R. .3 gpd/ft²

Septic Tank: 1000 Gallons; STB 825 Date 11-8-06
Pump Tank: _____ Gallons; PT _____ Date _____
Pump Make: _____ Model _____ Serial No. _____
Nitrification Field: No Fields 1 Square Feet 1200 Linear Feet 300
No Lines 3@100' Trench Width 36" Max Trench Bottom Depth 36" Gravel Depth NA

☒ New System ☐ Repair ☐ Expansion System Type: I (II) III IV V VI
System Description: 25% reduction gravity
Repair System Description: 25% reduction gravity
Maintenance Agreement Required: ☐ Yes ☒ No

☐ House/Mod. Home No. Bedrooms 3
☒ Mobile Home No. Persons 6
☐ Business No. Employees ____
☐ Other _____

Water Supply: ☒ Individual ☐ Public ☐ Community


☒ Gravity ☐ Pressure ☐ Slab ☒ Crawl Space ☐ Basement w/plumbing ☐ Basement wo/plumbing

Comments/Conditions: Trenches follow contour of the ground
Check driveway location before OP

Comments/Conditions: Blue Tuf-tite filter

1" = 50'

INITIAL SITE SKETCH

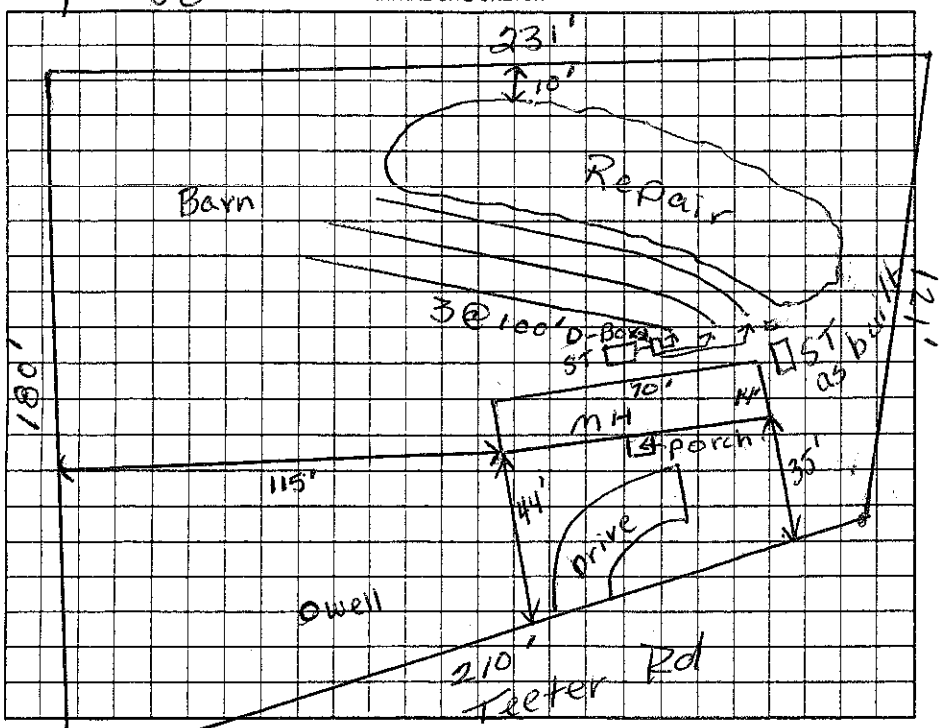

AS BUILT SKETCH

Quick-4 Infiltrator installed as per initial site sketch

5T installed to side of MH as shown

Permit can be suspended or revoked if any false information is supplied toward securing the permit/any unauthorized changes are made to the site/any unauthorized changes are made in the installation of the system. Improvement Permit with plat valid without expiration ☐ Improvement Permit with site plan valid for sixty months ☒ Authorization to Construct is valid for a period equal to that of Improvement Permit – not to exceed sixty months.

Signed: Jacob C Compton date 11-13-06 Installed by: Delbert Bostian (Bostian Backhoe)

Improvement Permit by: Judy Melvill date 11-7-06 Operation Permit by: Judy Melvill date 12-29-06

Authorization to Construct by: Judy Melvill date 11-13-06 Existing System Inspection by: _____ date _____

HEALTH DEPT. COPY: WHITE OWNER COPY (FINAL): YELLOW OWNER COPY (INITIAL): PINK