# IREDELL COUNTY HEALTH DEPARTMENT

Construct Auth

STATESVILLE 704-878-5305 MOORESVILLE 704-664-5281

4676869603

## IMPROVEMENT PERMIT / CERTIFICATE OF COMPLETION / OPERATION PERMIT / EXISTING SYSTEM INSPECTION

PROPERTY DESCRIPTION NO. 068786 DATE 8/15/97 TAX MAP NO. 4676869733

OWNER OR CONTRACTOR Donald Starnes PHONE: Business (704) 663-3364 Home

ADDRESS 471 Teeter Rd Mooresville, NC 28115 Watershed: ☐ Yes ☐ No

LOCATION Hwy 152 TR Teeter Rd on Left approx 1.3 Miles

SUBDIVISION Existing BLOCK / SECTION LOT LOT AREA 1.59 Acre SITE CLASS. DESIGN FLOW 360gpd L.T.A.R.

Septic Tank: 1250 gal Gallons; STB Date Existing

Pump Tank: Gallons; PT Date

Pump Make: Model Serial No.

Nitrification Field: No Fields 1 Square Feet 720 Linear Feet 240

No Lines 4 Trench Width Max Trench Bottom Depth Gravel Depth 12"

☐ New System ☐ Repair System Type: I (II) III, IV, V, VI

System Description: Existing Grav-Convent

Repair System Description:

Maintenance Agreement Required: ☐ Yes ☐ No

☐ House/Mod. Home ☒ Mobile Home ☐ Business ☐ Other

No. Bedrooms 3 No. Bathrooms No. Employees


☐ Slab ☒ Crawl Space ☐ Basement w/plumbing ☐ Basement wo/plumbing

Water Supply: ☒ Individual ☐ Community ☐ Public

Comments: Drainlines are very deep. Septic system appears to be functioning properly at time of inspection, no problems visible.

Comments: System was sized for 3 Bedroom 2 Bath at time of installation 11/82

INITIAL SITE SKETCH Not to Scale

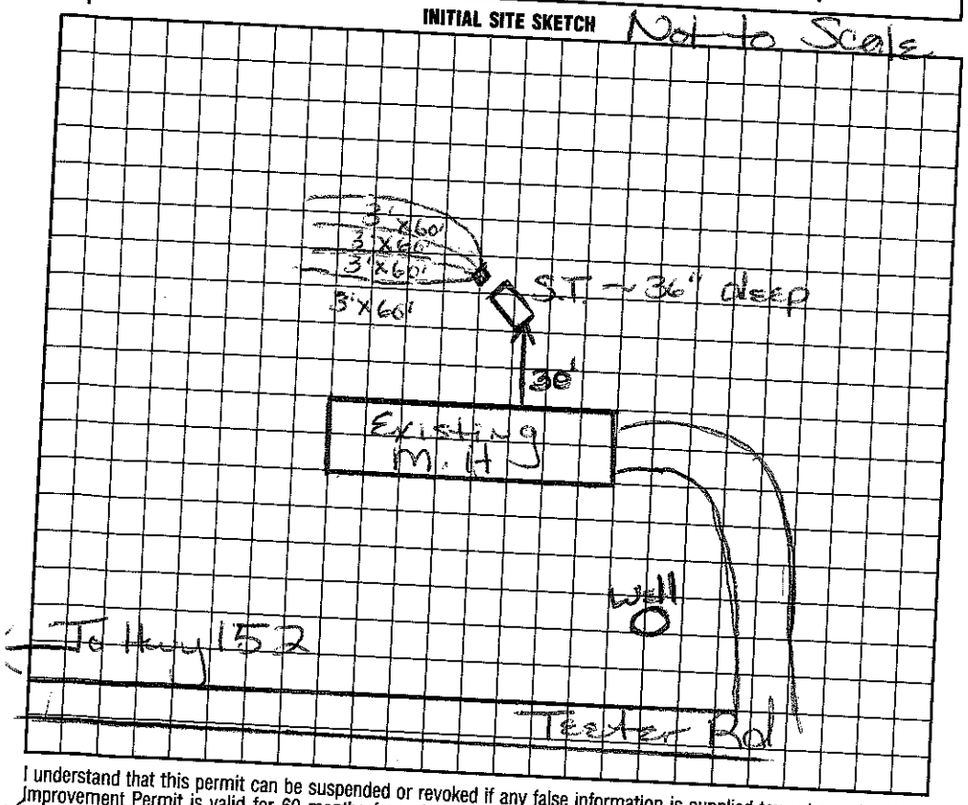


AS BUILT SKETCH

I understand that this permit can be suspended or revoked if any false information is supplied toward securing the permit/any unauthorized changes are made to the site/any unauthorized changes are made in the installation of the system. Improvement Permit is valid for 60 months from date of issuance.

Signed: Donald Wayne Starnes

Improvement Permit by: Maria H. Watson date 8/15/97

Existing System Inspection by: Maria H. Watson date 8/15/97

Installed by:

Certificate of Completion by: date

Operation Permit by: date

HEALTH DEPT. COPY: WHITE INSPECTION COPY (FINAL): GREEN OWNER COPY (FINAL): YELLOW INSPECTION COPY (INITIAL): PINK OWNER COPY (INITIAL): GOLD

S.T. Auth