IREDELL COUNTY HEALTH DEPARTMENT

LLE 704-878-5305 MOORESVILLE 704-664-5281

IMPROVEMENT PERMIT / AUTHORIZATION TO CONSTRUCT / OPERATION PERMIT / EXISTING SYSTEM INSPECTION

PERMIT# 108176 PIN# 4676-87-3496.8 DATE 8/20/02

OWNER OR CONTRACTOR Franklin Ray PHONE: Business Home 704-662-3617

ADDRESS 431 Teeter Rd Mooresville NC 28115

LOCATION 152 E, TR Linwood, TL Teeter, on Rt #437

SUBDIVISION BLOCK / SECTION LOT LOT AREA 1.464c SITE CLASS. PS DESIGN FLOW 240 L.T.A.R. 0.35

Septic Tank: 1000 Gallons; STB 794 Date 6/10/02
Pump Tank: Gallons; PT Date
Pump Make: Model Serial No.
Nitrification Field: No Fields 1 Square Feet 720 Linear Feet 240
No Lines 4 Trench Width 36" Max Trench Bottom Depth 36"

☒ New System ☐ Repair System Type: I, II, III, IV, V, VI
System Description: Gravity Conventional
Repair System Description: same
Maintenance Agreement Required: ☐ Yes ☒ No


☐ House/Mod. Home No. Bedrooms 2
☒ Mobile Home No. Bathrooms 2
☐ Business No. Employees
☐ Other
Gravel Depth 12" ☐ Slab ☒ Crawl Space ☐ Basement w/plumbing ☐ Basement wo/plumbing

Water Supply: ☒ Individual ☐ Public ☐ Community

Comments:/Conditions:
Install Drain Field on Contour

Comments:/Conditions:

INITIAL SITE SKETCH

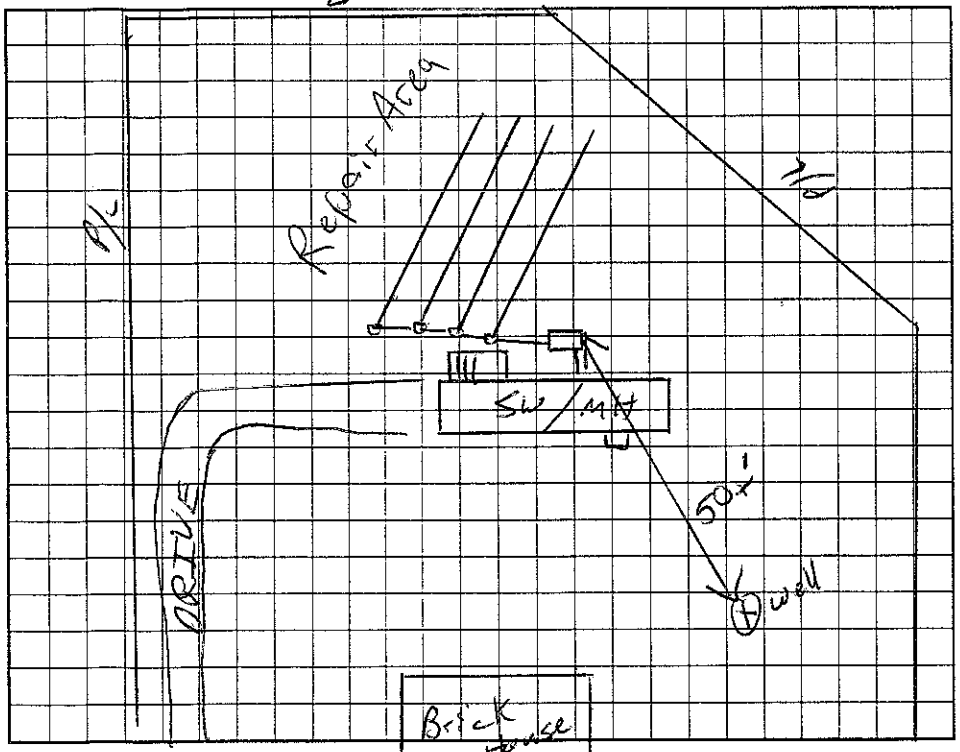

AS BUILT SKETCH

Permit can be suspended or revoked if any false information is supplied toward securing the permit/any unauthorized changes are made to the site/any unauthorized changes are made in the installation of the system. Improvement Permit with plat valid without expiration. Improvement Permit with site plan valid for sixty months. Authorization to Construct is valid for a period equal to that of Improvement Permit – not to exceed sixty months.

Signed: Franklin M Ray date 8-21-02 Installed by: Thomas Ray

Improvement Permit by: RS date 8/20/02 Operation Permit by: Wesley Sparks RS. date 10/8/02

Authorization to Construct by: RS date 8/20/02 Existing System Inspection by: date

HEALTH DEPT. COPY: WHITE OWNER COPY (FINAL): YELLOW OWNER COPY (INITIAL): PINK