IREDELL COUNTY HEALTH DEPARTMENT

STATESVILLE 704-878-5305 MOORESVILLE 704-664-5281

IMPROVEMENT PERMIT / AUTHORIZATION TO CONSTRUCT / OPERATION PERMIT / EXISTING SYSTEM INSPECTION

PERMIT# 109655 PIN# 4676-87-5205 DATE 11/12/02

OWNER OR CONTRACTOR Jacob Compton PHONE: Business Home 704-663-1734

ADDRESS 441 Teeter Rd Mooresville NC 28115

LOCATION Linwood, TL Teeter, on Rt behind #441

SUBDIVISION BLOCK / SECTION LOT LOT AREA 2.03 AC SITE CLASS. PS DESIGN FLOW 360 L.T.A.R. 0.35

Septic Tank: 1000 Gallons; ST RST828 Date 9-29-02

Pump Tank: Gallons; PT Date

Pump Make: Model Serial No.

Nitrification Field: No Fields 1 Square Feet 1055 Linear Feet 345

No Lines 3 @ 115' Trench Width 36" Max Trench Bottom Depth 36" Gravel Depth 12"

☒ New System ☐ Repair System Type: I (II) III. IV. V. VI

System Description: Gravity Conventional

Repair System Description: same

Maintenance Agreement Required: ☐ Yes ☒ No

☐ House/Mod. Home No. Bedrooms 3

☒ Mobile Home No. Bathrooms 2

☐ Business No. Employees

☐ Other

☐ Slab ☒ Crawl Space ☐ Basement w/plumbing ☐ Basement wo/plumbing


Water Supply: ☒ Individual ☐ Public ☐ Community

shared


Comments./Conditions:

Comments:/Conditions: Blue Polylok filter installed

INITIAL SITE SKETCH

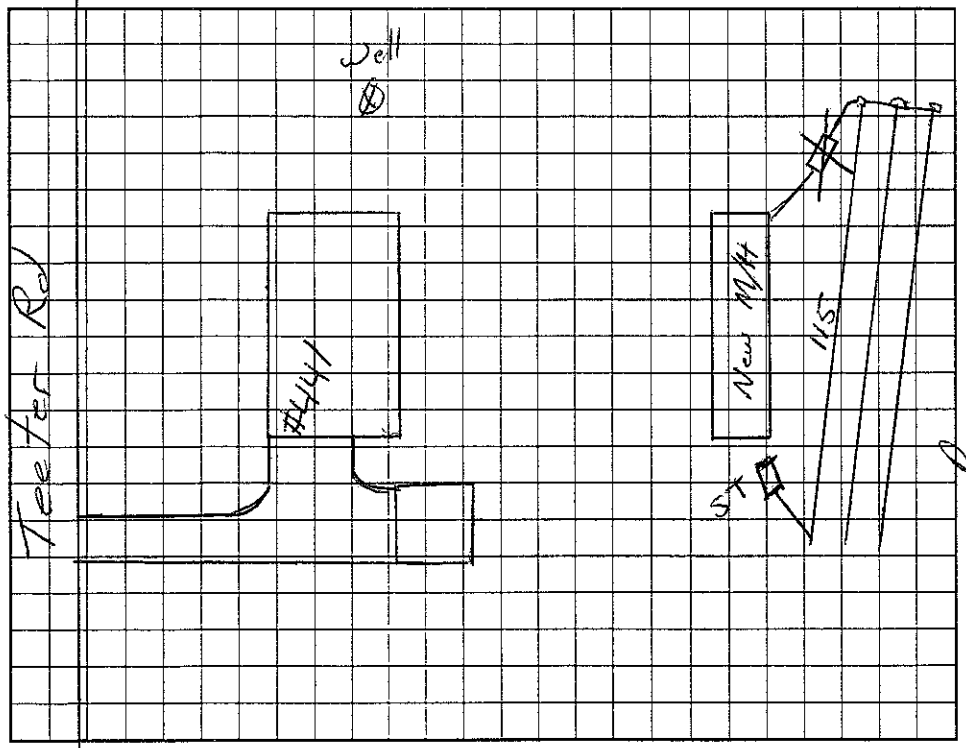

AS BUILT SKETCH

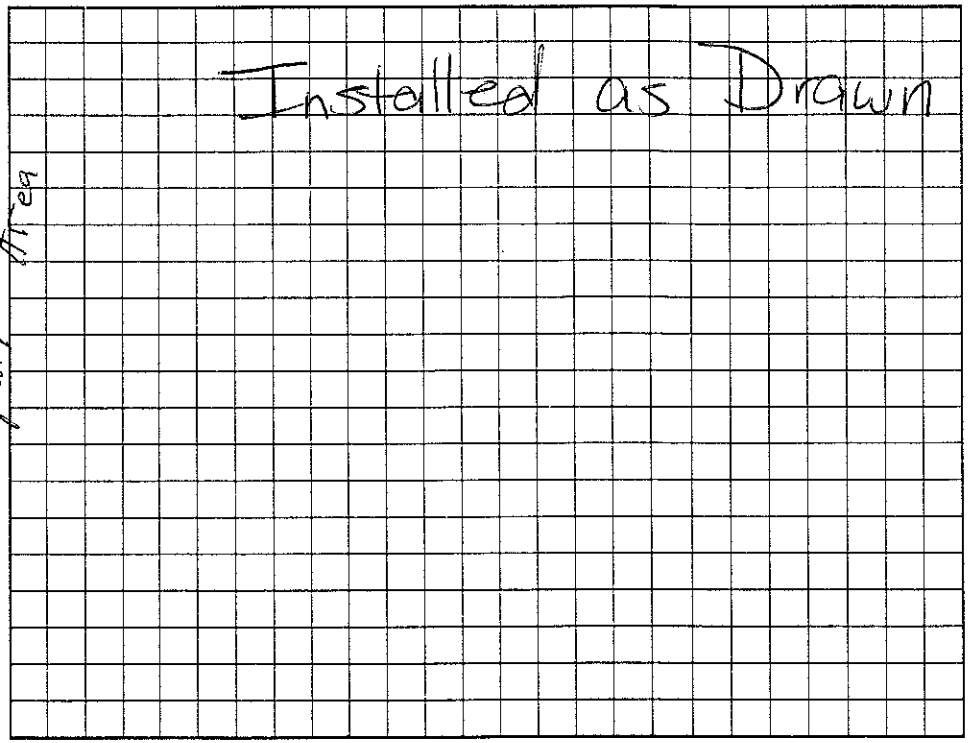

Permit can be suspended or revoked if any false information is supplied toward securing the permit/any unauthorized changes are made to the site/any unauthorized changes are made in the installation of the system. Improvement Permit with plat valid without expiration. Improvement Permit with site plan valid for sixty months. Authorization to Construct is valid for a period equal to that of Improvement Permit – not to exceed sixty months.

Signed: Jacob C Compton date 11-12-02

Improvement Permit by: RS date 11/12/02

Authorization to Construct by: RS date 11/12/02

Installed by: Delbert Bastian RS

Operation Permit by: Maria H. Coleman date 11/22/2002

Existing System Inspection by: date

HEALTH DEPT. COPY: WHITE OWNER COPY (FINAL): YELLOW OWNER COPY (INITIAL): PINK