IREDELL COUNTY HEALTH DEPARTMENT

STATESVILLE 704-878-5305 MOORESVILLE 704-664-5281

IMPROVEMENT PERMIT / AUTHORIZATION TO CONSTRUCT / OPERATION PERMIT / EXISTING SYSTEM INSPECTION

PERMIT# 109017 PIN# ~~4676 87 8353~~ 4676 87 7619 DATE 10/8/02

OWNER OR CONTRACTOR William Chatham PHONE: Business Home 704-663-5522

ADDRESS 415 Teeter Rd, Mooresville, NC. 28115 419 Teeter Rd.

LOCATION 150 East TR 152 TR Teeter Rd. on (L) west 415 Teeter Rd.

SUBDIVISION No BLOCK / SECTION LOT LOT AREA ~ 2 AC SITE CLASS. PS DESIGN FLOW 360 L.T.A.R. .3

Septic Tank: 1000 Gallons; STB 312 Date 12/8/02

Pump Tank: Gallons; PT Date

Pump Make: Model Serial No.

Nitrification Field: No Fields 1 Square Feet 1200 Linear Feet 400

No Lines 3 @ 133' Trench Width 3' Max Trench Bottom Depth 36" Gravel Depth 12"

[X] New System [ ] Repair System Type: I (II) III IV V VI

System Description: Drawing-Conventional

Repair System Description:

Maintenance Agreement Required: [ ] Yes [X] No

[ ] House/Mod. Home No. Bedrooms 3

[X] Mobile Home No. Bathrooms 2

[ ] Business No. Employees

[ ] Other

[ ] Slab [X] Crawl Space [ ] Basement w/plumbing [ ] Basement wo/plumbing


Water Supply: [X] Individual [ ] Public [ ] Community (FATHERS)

Comments:/Conditions:


P/L

Comments:/Conditions:

INITIAL SITE SKETCH

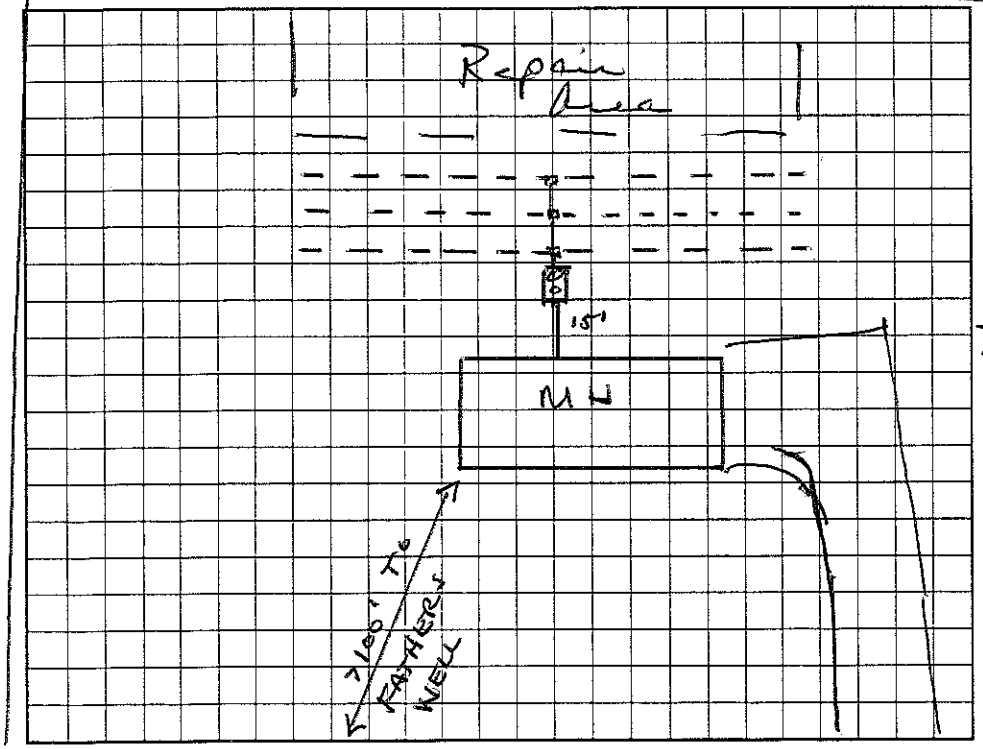

AS BUILT SKETCH

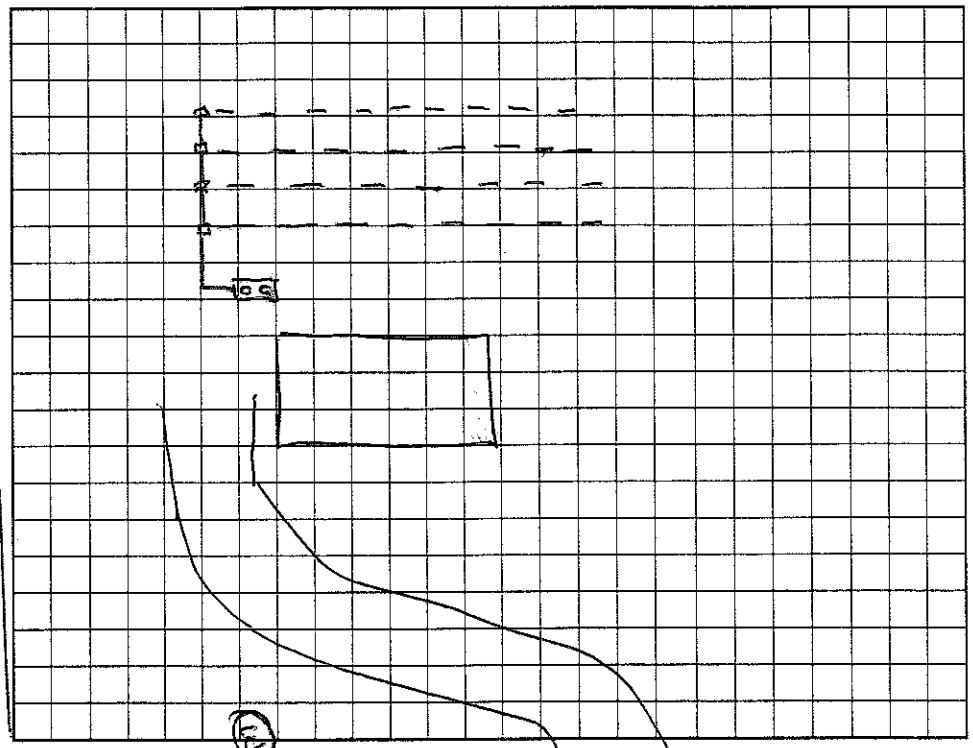

Permit can be suspended or revoked if any false information is supplied toward securing the permit/any unauthorized changes are made to the site/any unauthorized changes are made in the installation of the system. Improvement Permit with plat valid without expiration. Improvement Permit with ~~site plan~~ valid for sixty months. Authorization to Construct is valid for a period equal to that of Improvement Permit – not to exceed sixty months.

Signed: X William M. Chatham date

Improvement Permit by: Wesley Sparks R.S. date 10/8/02

Authorization to Construct by: Wesley Sparks R.S. date 10/8/02

Installed by: Larry Beam

Operation Permit by: Wesley Sparks R.S. date 1/13/03

Existing System Inspection by: date

HEALTH DEPT. COPY: WHITE OWNER COPY (FINAL): YELLOW OWNER COPY (INITIAL): PINK