(3:30)

IREDELL COUNTY HEALTH DEPARTMENT

STATESVILLE 704-878-5305 MOORESVILLE 704-664-5281

IMPROVEMENT PERMIT / AUTHORIZATION TO CONSTRUCT / OPERATION PERMIT / EXISTING SYSTEM INSPECTION

PERMIT# 082986 PIN# ~~4677 80 9201 PT.~~ 4676-89-3525 DATE 8/19/99

OWNER OR CONTRACTOR COMPETITIVE EDGE CONST. PHONE: Business 663-4433 Home

ADDRESS PO BOX 770 MOORESVILLE, NC. 28115

LOCATION 1365 TL WILLIFORD RD. TR LINWOOD TL TEETER ~ 1.5 MILES ON (R) TR MAGNOLIA RIDGE DR TR OAKWOOD RIDGE DR.

SUBDIVISION MAGNOLIA RIDGE BLOCK / SECTION LOT 8 LOT AREA 1.0 AC SITE CLASS. PS DESIGN FLOW 360 L.T.A.R. .25

Septic Tank: 1000 Gallons; STB 1012 Date 9/8/99
Pump Tank: Gallons; PT Date
Pump Make: Model Serial No.
Nitrification Field: No Fields 1 Square Feet 1440 Linear Feet 480
No Lines 4 Trench Width 36" Max Trench Bottom Depth 36" Gravel Depth 12"


[X] New System [ ] Repair System Type: I, II, III, IV, V, VI
System Description: GRAV - CONVENTIONAL
Repair System Description: GRAV - CH. PLASTIC
Maintenance Agreement Required: [ ] Yes [X] No

[X] House/Mod. Home No. Bedrooms 3
[ ] Mobile Home No. Bathrooms 4
[ ] Business No. Employees
[ ] Other
[ ] Slab [ ] Crawl Space [X] Basement w/plumbing [ ] Basement wo/plumbing

Water Supply: [X] Individual [ ] Public [ ] Community


Comments:/Conditions: (1" = 50')

INITIAL SITE SKETCH

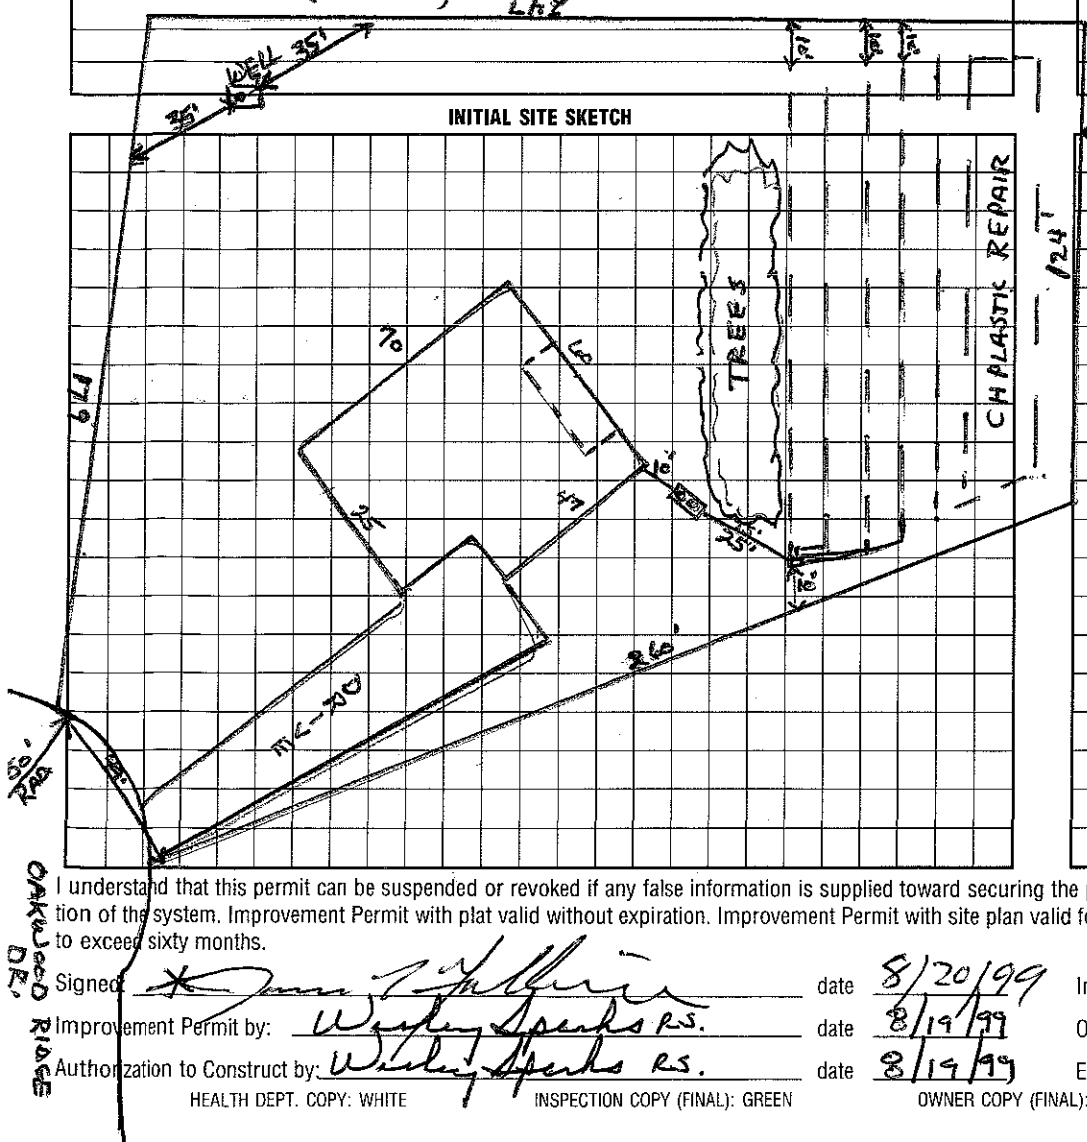

Comments:/Conditions:

AS BUILT SKETCH

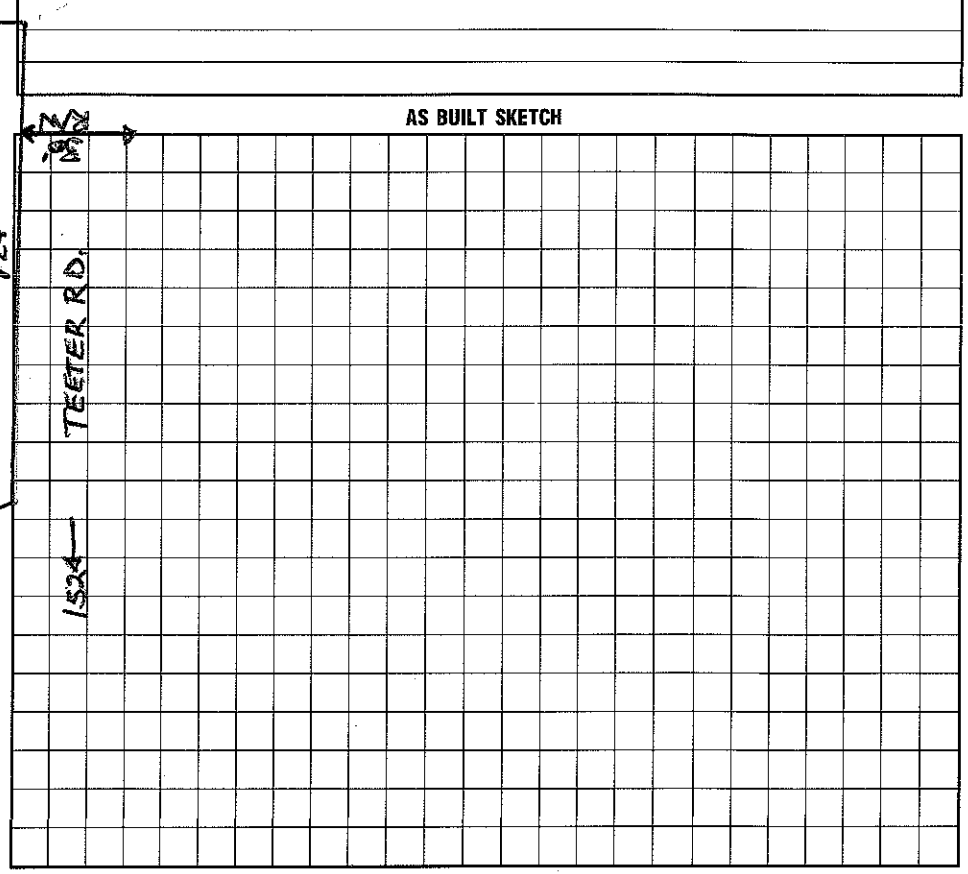

I understand that this permit can be suspended or revoked if any false information is supplied toward securing the permit/any unauthorized changes are made to the site/any unauthorized changes are made in the installation of the system. Improvement Permit with plat valid without expiration. Improvement Permit with site plan valid for sixty months. Authorization to Construct is valid for a period equal to that of Improvement Permit – not to exceed sixty months.

Signed [signature] date 8/20/99 Installed by: A-1 Backhoe

Improvement Permit by: Wesley Sparks R.S. date 8/19/99 Operation Permit by: Wesley Sparks R.S. date 11/23/99

Authorization to Construct by: Wesley Sparks R.S. date 8/19/99 Existing System Inspection by: date

HEALTH DEPT. COPY: WHITE INSPECTION COPY (FINAL): GREEN OWNER COPY (FINAL): YELLOW INSPECTION COPY (INITIAL): PINK OWNER COPY (INITIAL): GOLD