IREDELL COUNTY HEALTH DEPARTMENT

STATESVILLE 704-878-5305 150.00 Paid MOORESVILLE 704-664-5281

IMPROVEMENT PERMIT / AUTHORIZATION TO CONSTRUCT / OPERATION PERMIT / EXISTING SYSTEM INSPECTION

PERMIT# 107521 PIN# 4676 89 6712 DATE

OWNER OR CONTRACTOR Justin Nottestad PHONE: Business 980-721-9701 Home 704-662-9701

ADDRESS 203 Bradford Glyn Dr Mooresville NC 28115

LOCATION Linwood, TL Tecter, TR Magnolia Ridge, TR Oak Meadow, on Lt at end

SUBDIVISION Magnolia Ridge BLOCK / SECTION LOT 10 LOT AREA 1.00 Ac SITE CLASS PS DESIGN FLOW 480 L.T.A.R. 0.35

Septic Tank: ~~1000~~ 1500 Gallons; STB 444 Date 3/26/06

Pump Tank: Gallons; PT Date

Pump Make: Model Serial No.

Nitrification Field: No Fields 1 Square Feet 1035 Linear Feet 345'

No Lines 3 Trench Width 36" Max Trench Bottom Depth 36" Gravel Depth —

☒ New System ☐ Repair System Type: I (II) III IV V VI

System Description: Gravity 25% Reduction

Repair System Description: Pump 25% Reduction

Maintenance Agreement Required: ☐ Yes ☒ No

☒ House/Mod. Home ☐ Mobile Home ☐ Business ☐ Other

No. Bedrooms 4 No. Bathrooms No. Employees

Water Supply: ☒ Individual ☐ Public ☐ Community


☐ Slab ☐ Crawl Space ☒ Basement w/plumbing ☐ Basement wo/plumbing

Comments:/Conditions:


Oak Meadow

Comments:/Conditions:

INITIAL SITE SKETCH

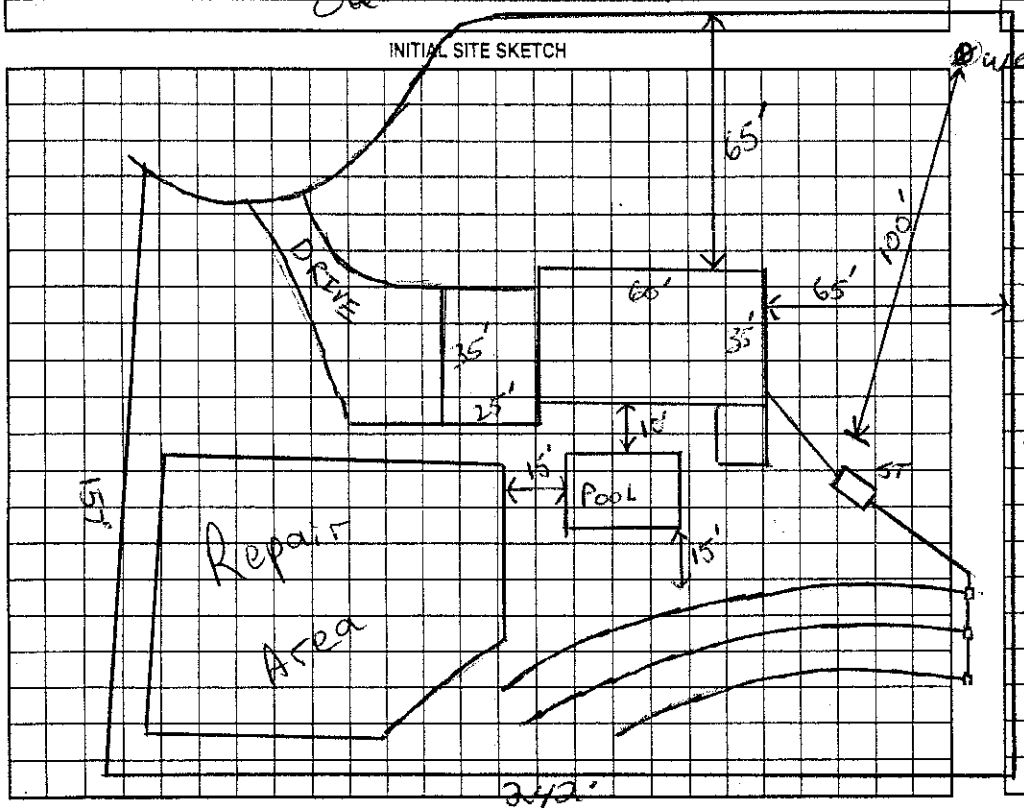

AS BUILT SKETCH

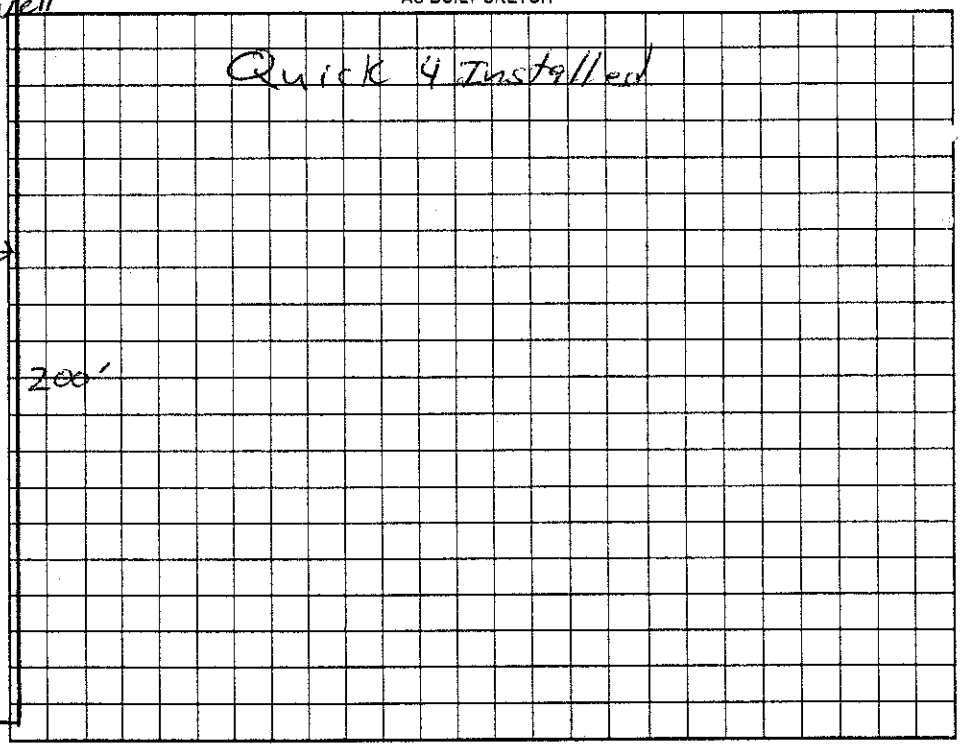

Permit can be suspended or revoked if any false information is supplied toward securing the permit/any unauthorized changes are made to the site/any unauthorized changes are made in the installation of the system. Improvement Permit with plat valid without expiration. Improvement Permit with site plan valid for sixty months. Authorization to Construct is valid for a period equal to that of Improvement Permit – not to exceed sixty months.

Signed: Julie Nottestad date 8/4/05 Installed by: Piedmont Septic

Improvement Permit by: RS date 8/3/05 Operation Permit by: RS date 5/3/06

Authorization to Construct by: RS date 1/26/06 Existing System Inspection by: date

HEALTH DEPT. COPY: WHITE OWNER COPY (FINAL): YELLOW OWNER COPY (INITIAL): PINK