# IREDELL COUNTY HEALTH DEPARTMENT

STATESVILLE 704-878-5305 MOORESVILLE 704-664-5281

## IMPROVEMENT PERMIT / AUTHORIZATION TO CONSTRUCT / OPERATION PERMIT / EXISTING SYSTEM INSPECTION

PERMIT# 065716 PIN# 4677708781 DATE 12-18-97

OWNER OR CONTRACTOR Michael March PHONE: Business _____ Home 663-4990

ADDRESS 107 Scotland Dr. Mooresville, NC 28115

LOCATION Hwy 152 E TR Teeter Rd Approx ½ mile on left

SUBDIVISION _____ BLOCK / SECTION _____ LOT _____ LOT AREA 39 Acres SITE CLASS. PS DESIGN FLOW 480 gpd L.T.A.R. .3

Septic Tank: 1000 Gallons; STB 794 Date 4/16/98
Pump Tank: _____ Gallons; PT _____ Date _____
Pump Make: _____ Model _____ Serial No. _____
Nitrification Field: No Fields 1 Square Feet 1605 Linear Feet 535'
No Lines 5 at 107' Trench Width 36" Max Trench Bottom Depth 36" Gravel Depth 12"

☒ New System ☐ Repair System Type: I, II, III, IV, V, VI
System Description: Gravity - Conventional
Repair System Description: Pump - Conventional
Maintenance Agreement Required: ☐ Yes ☒ No


☒ House/Mod. Home No. Bedrooms 4
☐ Mobile Home No. Bathrooms 2.5
☐ Business No. Employees _____
☐ Other _____
☐ Slab ☐ Crawl Space ☐ Basement w/plumbing ☒ Basement wo/plumbing

Water Supply: ☒ Individual ☐ Public ☐ Community

Comments:/Conditions: Keep well 100' from Septic System

Comments:/Conditions:

**INITIAL SITE SKETCH** Scale 1:60

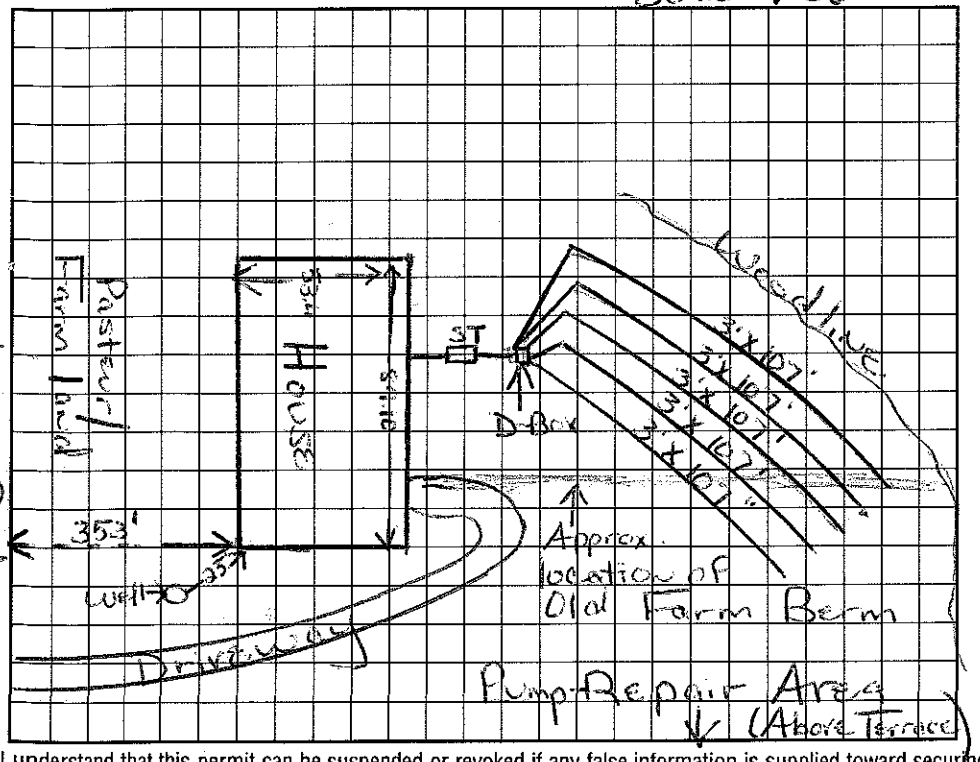


**AS BUILT SKETCH**

I understand that this permit can be suspended or revoked if any false information is supplied toward securing the permit/any unauthorized changes are made to the site/any unauthorized changes are made in the installation of the system. Improvement Permit with plat valid without expiration. Improvement Permit with site plan valid for sixty months. Authorization to Construct is valid for a period equal to that of Improvement Permit – not to exceed sixty months.

Signed: _____ date 3-19-98
Improvement Permit by: Marian H. Eaton date 12/18/97
Authorization to Construct by: Marian H. Eaton date 12/18/97

Installed by: Buddy Chaney
Operation Permit by: Wesley Sparks RS date 5/27/98
Existing System Inspection by: Wesley Sparks RS date 5/27/98

HEALTH DEPT. COPY: WHITE INSPECTION COPY (FINAL): GREEN OWNER COPY (FINAL): YELLOW INSPECTION COPY (INITIAL): PINK OWNER COPY (INITIAL): GOLD