Site Address: 191 Rain Shadow Drive - Mark

IREDELL COUNTY HEALTH DEPARTMENT

STATESVILLE 704-878-5305 MOORESVILLE 704-664-5281

IMPROVEMENT PERMIT / AUTHORIZATION TO CONSTRUCT / OPERATION PERMIT / EXISTING SYSTEM INSPECTION

PERMIT# 149052 218979 PIN# ~~4676956328 old~~ NEW PIN 4676 94 2435 DATE 8-19-2008

OWNER OR APPLICANT DAVID R. MOONY, LLC/BUCH CAROLINA PHONE: Business 704-664-9080 Home

ADDRESS 505 TEETER RD. MOORESVILLE, NC 28115

LOCATION 152 E TR TEETER RD. Approx 2 mi TL HoneyBrook Subd. To Cul-de-sac on LEFT

SUBDIVISION HoneyBrook BLOCK / SECTION — LOT 12 LOT AREA 1.603 SITE CLASS. PS DESIGN FLOW 480 L.T.A.R. .3 GPD/FT²

Septic Tank: 1000 Gallons; STB 794 Date 8/11/16
Pump Tank: ____ Gallons; PT ____ Date ____
Pump Make: ____ Model ____ Serial No. ____
Nitrification Field: No Fields 1 Square Feet ____ Linear Feet 400'
No Lines 3 Trench Width 36" Max Trench Bottom Depth 36" Gravel Depth ____

☒ New System ☐ Repair ☐ Expansion System Type: I II III IV V VI
System Description: 25% REDUCTION
Repair System Description: 25% REDUCTION
Maintenance Agreement Required: ☐ Yes ☒ No

☒ House/Mod. Home No. Bedrooms 4
☐ Mobile Home No. Persons ____
☐ Business No. Employees ____
☐ Other ____

Water Supply: ☒ Individual ☐ Public ☐ Community

☐ Gravity ☐ Pressure ☐ Slab ☒ Crawl Space ☐ Basement w/plumbing ☐ Basement wo/plumbing

Comments/Conditions: ANY WELL MUST BE LOCATED MINIMUM 100' FROM THIS OR AN SEPTIC SYSTEM.

Comments/Conditions: Installed per drawing

INITIAL SITE SKETCH

* SEE PLAN FROM WASTEWATER SOLUTIONS
STEVE CARLEY - CASS CONSULTANTS INC.

AS BUILT SKETCH

Permit can be suspended or revoked if any false information is supplied toward securing the permit/any unauthorized changes are made to the site/any unauthorized changes are made in the installation of the system. Improvement Permit with plat valid without expiration ☐ Improvement Permit with site plan valid for sixty months ☒ Authorization to Construct is valid for a period equal to that of Improvement Permit – not to exceed sixty months.

Signed: [signature] date 11-13-07

Improvement Permit by: [signature] R.S. date 2-29-08 CTA


Authorization to Construct by: Wesley Sparks date 7-13-16

Installed by: Wastewater Solutions

Operation Permit by: W Sparks date 9/13/16

Existing System Inspection by: ____ date ____

HEALTH DEPT. COPY: WHITE OWNER COPY (FINAL): YELLOW OWNER COPY (INITIAL): PINK

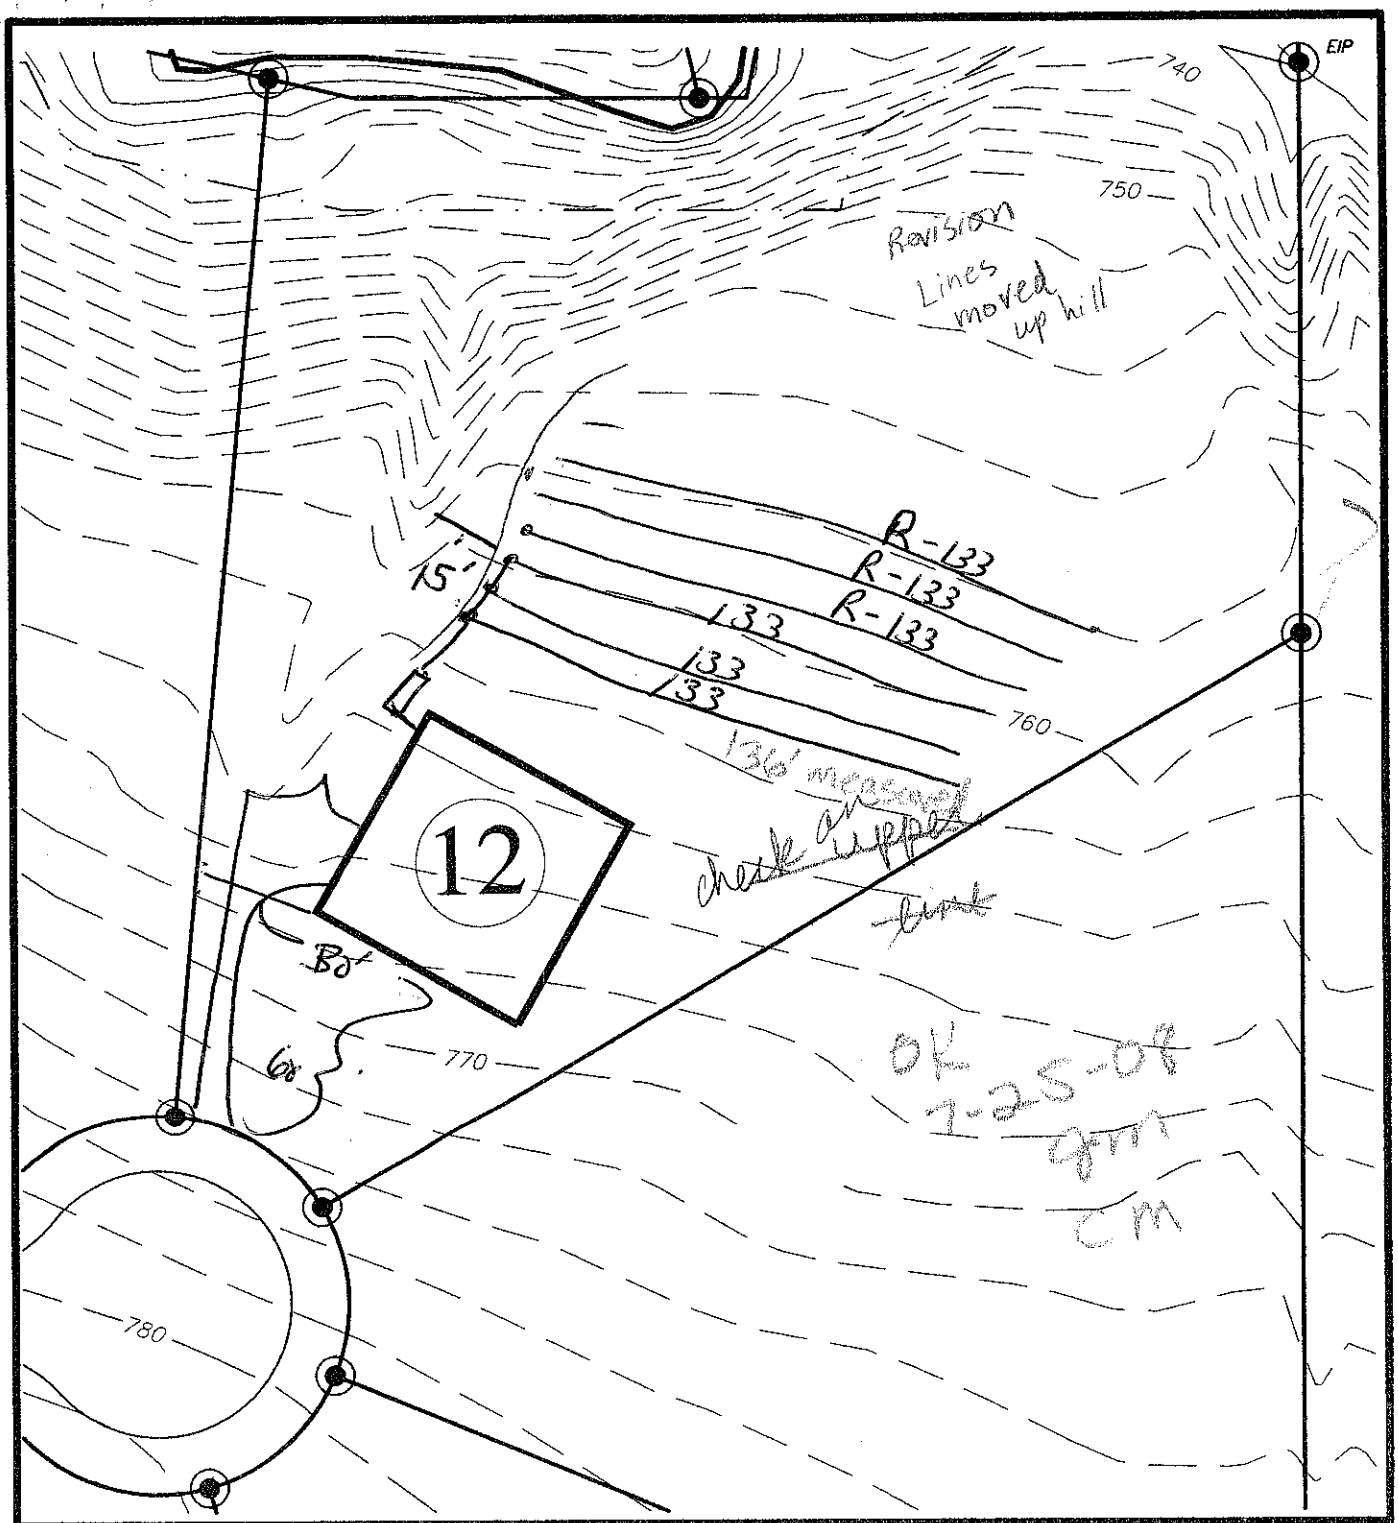

Hollybrook

FOR

DAVID R. MCKAY, LLC. & BETTY MCKAY, LLC.

505 TEETER ROAD
Mooresville, NC 28115
(704) 664-9080

IREDELL COUNTY; CODDLE CREEK NORTH CAROLINA

SEPTIC FIELD LAYOUT
LOT # 12

BAR SCALE 1"=50'

0 25 50 100