IREDELL COUNTY HEALTH DEPARTMENT

STATESVILLE 704-878-5305 MOORESVILLE 704-664-5281

IMPROVEMENT PERMIT / AUTHORIZATION TO CONSTRUCT / OPERATION PERMIT / EXISTING SYSTEM INSPECTION

PERMIT# 148997/197050 PIN# 4676855328.005 4676 95 0128 DATE 8-14-2008

OWNER OR APPLICANT David R. McCoy LLC / Jamie Morris PHONE: Business 664-9080 Home

ADDRESS 505 TEETER RD. MOORESVILLE, NC 28115

LOCATION Hwy 152 E TR TEETER RD. Approx. 2 miles on L 5TH lot on R

SUBDIVISION Honeybrook BLOCK / SECTION LOT 5 LOT AREA 1.002 SITE CLASS. P5 DESIGN FLOW 480 L.T.A.R. .3 GPD/FT²

Septic Tank: 1000 Gallons: ST8 Date

Pump Tank: Gallons: PT Date

Pump Make: Model Serial No.

Nitrification Field: No Fields 1 Square Feet Linear Feet 400'

No Lines 7 Trench Width 36" Max Trench Bottom Depth 24"

☒ New System ☐ Repair ☐ Expansion System Type: I II III IV V VI

System Description: 25% REDUCTION gravity

Repair System Description: 4p- PPBPS .25 Repair

Maintenance Agreement Required: ☐ Yes ☒ No

Gravel Depth N/A ☒ Gravity ☐ Pressure

☒ House/Mod. Home ☐ Mobile Home ☐ Business ☐ Other

No. Bedrooms 4 No. Persons No. Employees


Water Supply: ☒ Individual ☐ Public ☐ Community

☐ Slab ☒ Crawl Space ☐ Basement w/plumbing ☐ Basement wo/plumbing


Comments:/Conditions: 3 lines centerfed, 1 line endfed

Comments:/Conditions: System shifted up hill and due to fill material Line Lenghts had to change.

INITIAL SITE SKETCH

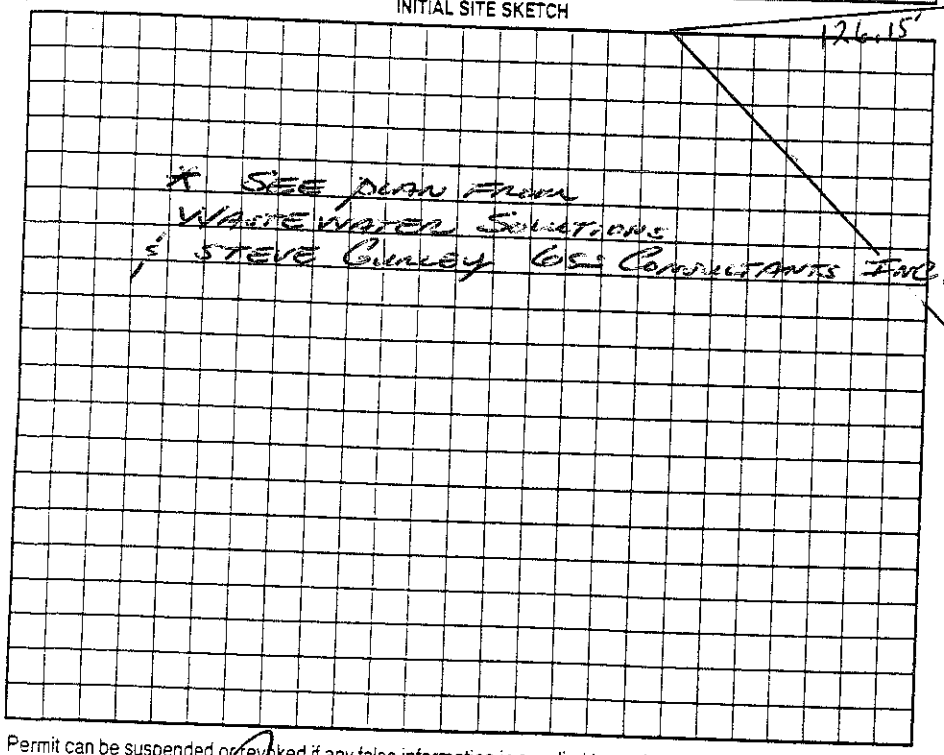

AS BUILT SKETCH

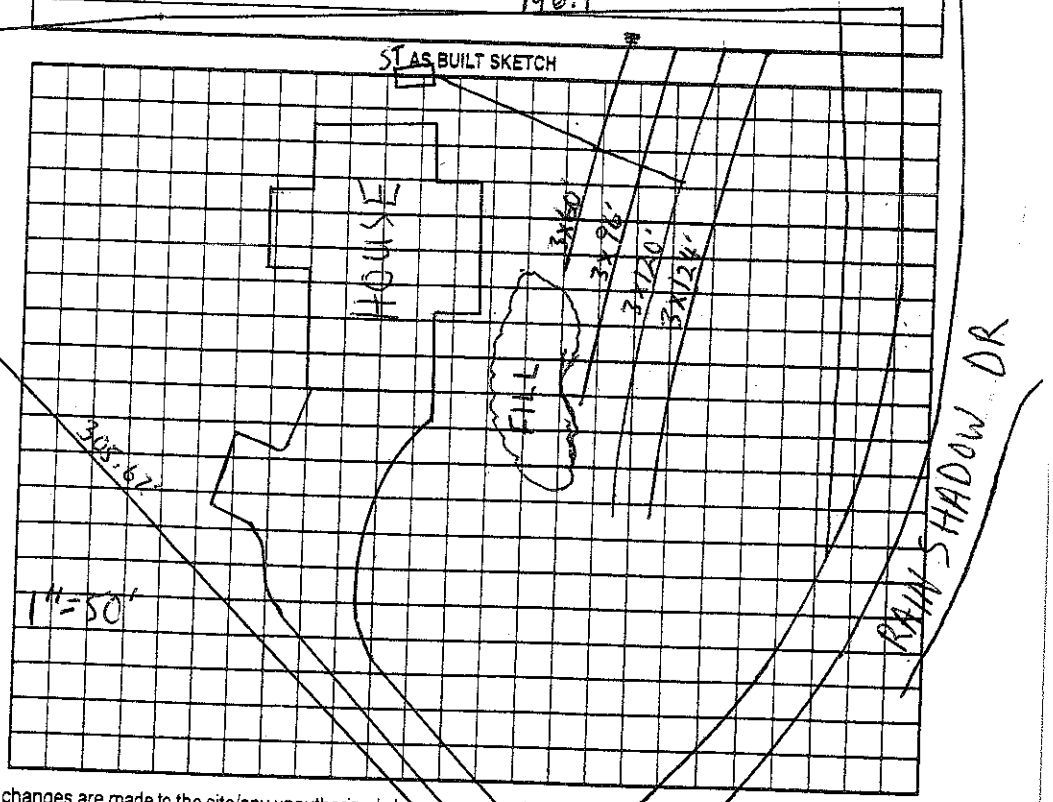

Permit can be suspended or revoked if any false information is supplied toward securing the permit/any unauthorized changes are made to the site/any unauthorized changes are made in the installation of the system. Improvement Permit with plat valid without expiration ☐ Improvement Permit with site plan valid for sixty months ☒ Authorization to Construct is valid for a period equal to that of Improvement Permit – not to exceed sixty months.

Signed: [signature] date 11-13-08 Installed by: RST

Improvement Permit by: [signature] R.S. date 8-15-08 Operation Permit by: Alan L. Pruitt date 9-18-13

Authorization to Construct by: [signature] date 2-19-13 Existing System Inspection by: date

HEALTH DEPT. COPY: WHITE OWNER COPY (FINAL): YELLOW OWNER COPY (INITIAL): PINK