Site Address: 111 Arensong Ct. - Mooresville

11:30-11:45

IREDELL COUNTY HEALTH DEPARTMENT

STATESVILLE 704-878-5305 MOORESVILLE 704-664-5281

IMPROVEMENT PERMIT / AUTHORIZATION TO CONSTRUCT / OPERATION PERMIT / EXISTING SYSTEM INSPECTION

PERMIT# 1492408 209248 PIN# 4676956328.000 4676-96-0651 DATE 8-22-08

OWNER OR APPLICANT David R. McKay, LLC / Branch of NC PHONE: Business 704-664-9080 Home

ADDRESS 505 Teeter Rd. Mooresville, NC 28115

LOCATION I-52 E to Rt Teeter Rd. Go approx. 2 mi Tl Hollybrook Subv. Tl Arensong Lane Lot on L

SUBDIVISION Hollybrook BLOCK / SECTION LOT 26 LOT AREA 1.693 AC SITE CLASS. PS DESIGN FLOW 480 L.T.A.R. .3 GPD/FT²

Septic Tank: 1000 Gallons; STB 794 Date 6-1-16

Pump Tank: Gallons; PT Date

Pump Make: Model Serial No.

Nitrification Field: No Fields 1 Square Feet Linear Feet 400'

No Lines 3@133' Trench Width 36" Max Trench Bottom Depth 36" Gravel Depth N/A

☒ New System ☐ Repair ☐ Expansion System Type: I II III IV V VI

System Description: 25% Reduction

Repair System Description: Pump to Pm 25% Red

Maintenance Agreement Required: ☐ Yes ☒ No

☒ House/Mod. Home ☐ Mobile Home ☐ Business ☐ Other

No. Bedrooms 4 No. Persons No. Employees

Water Supply: ☒ Individual ☐ Public ☐ Community

☐ Gravity ☐ Pressure ☐ Slab ☒ Crawl Space ☐ Basement w/plumbing ☐ Basement wo/plumbing

Comments/Conditions: Stub out @ House No more than 4" Below Grade!

** Do not cut for housepad, will result in revoking permit & pump required.

INITIAL SITE SKETCH

* See plan from Wastewater Solutions & Steve Gurney - GSS Consultants Inc.

Comments/Conditions: 3/22/16 Reviewed Floor plans, in Compliance with Septic plan House slightly larger but should still work.

AS BUILT SKETCH

Lowest line left off sketch. Installed Quick 4 essentially as drawn.


Permit can be suspended or revoked if any false information is supplied toward securing the permit/any unauthorized changes are made to the site/any unauthorized changes are made in the installation of the system. Improvement Permit with plat valid without expiration ☐ Improvement Permit with site plan valid for sixty months ☒ Authorization to Construct is valid for a period equal to that of Improvement Permit – not to exceed sixty months.

Signed: date 11-13-08 Installed by: Russell Williams

Improvement Permit by: R.S. date 8-22-08 Operation Permit by: Maria Dotson R.S. date 7/7/16

Authorization to Construct by: Maria Dotson R.S. date 3/22/16 Existing System Inspection by: date

HEALTH DEPT. COPY: WHITE OWNER COPY (FINAL): YELLOW OWNER COPY (INITIAL): PINK

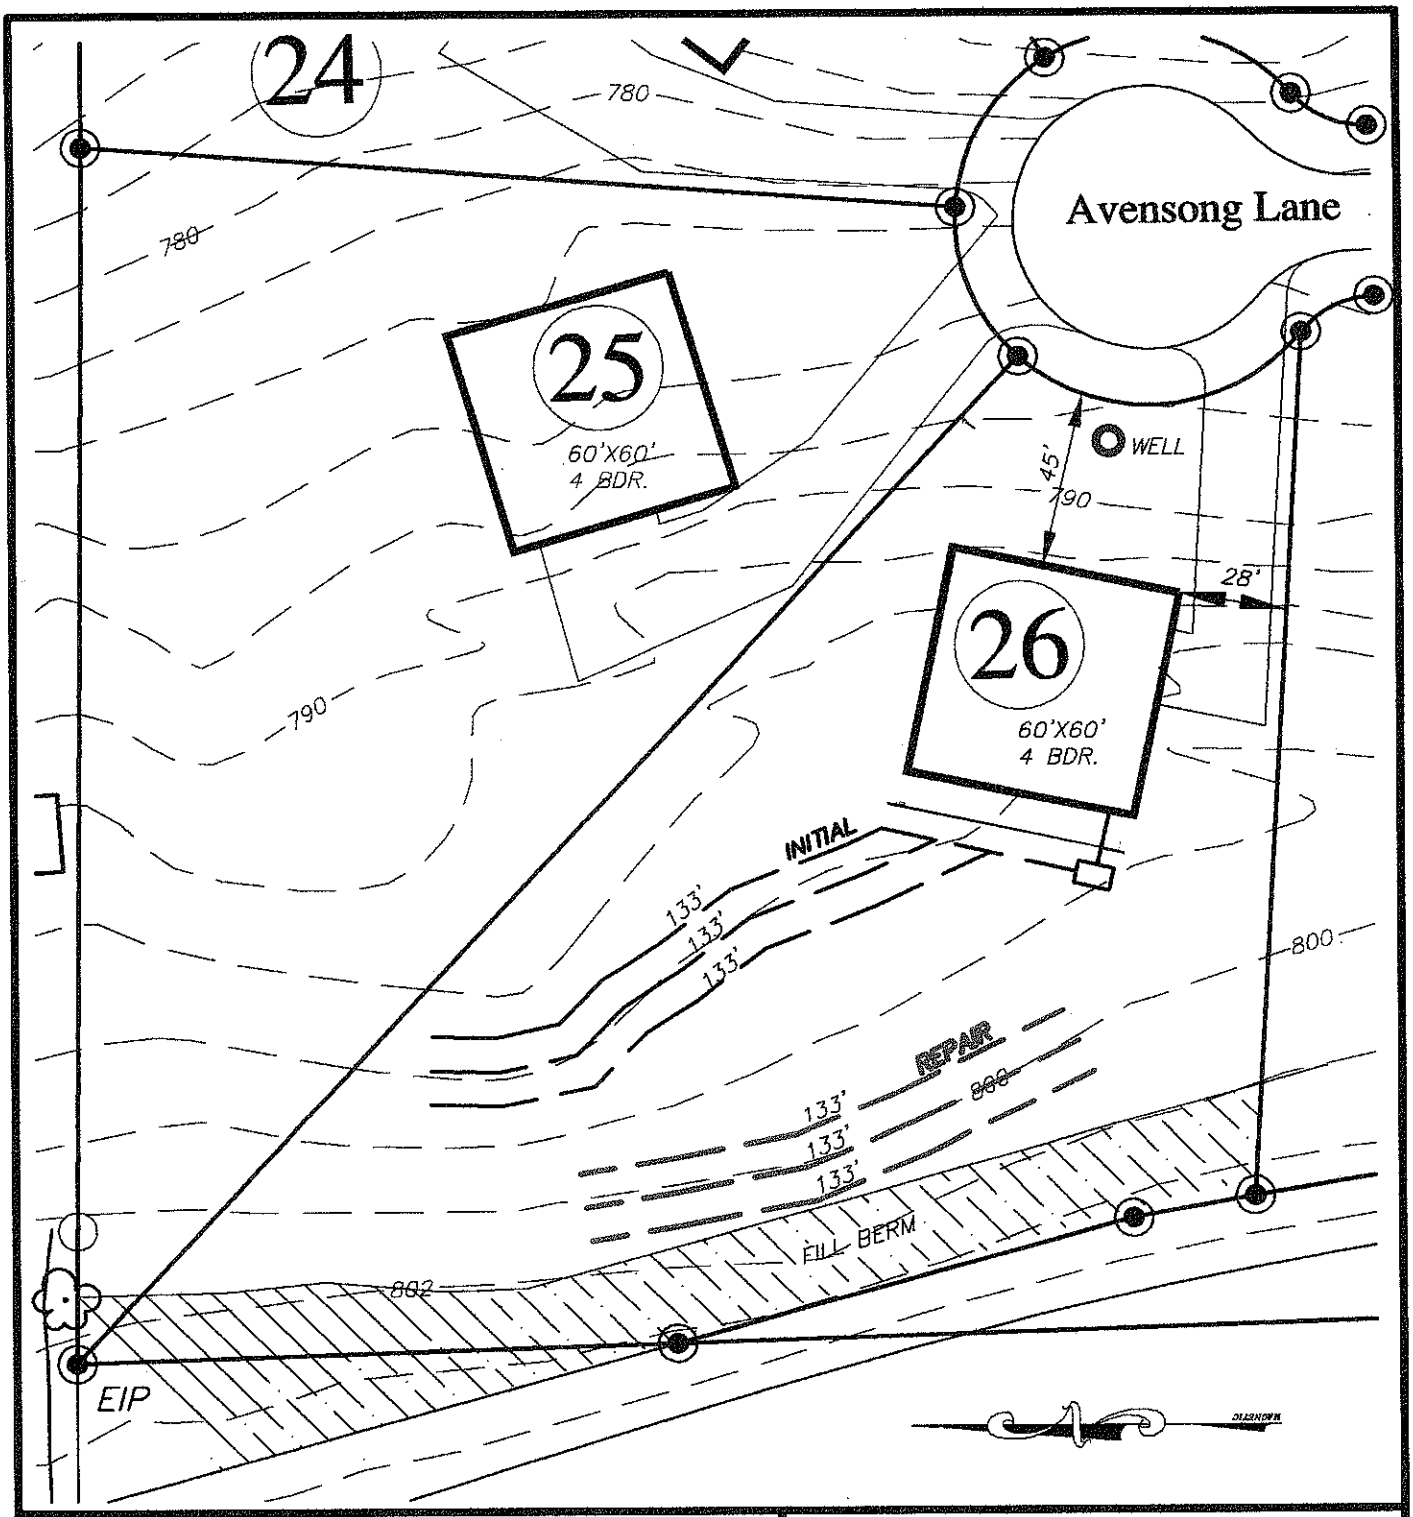

Hollybrook

FOR

DAVID R. MCKAY, LLC. & BETTY MCKAY, LLC.

505 TEETER ROAD
Mooresville, NC 28115
(704) 664-9080

IREDELL COUNTY; CODDLE CREEK NORTH CAROLINA

SEPTIC FIELD LAYOUT
LOT # 26

BAR SCALE 1"=50'

0 25 50 100