IREDELL COUNTY HEALTH DEPARTMENT

Statesville Office (704) 878-5305 Mooresville Office (704) 660-3625 PERMIT # 238993

SEPTIC IMPROVEMENT PERMIT / AUTHORIZATION TO CONSTRUCT / OPERATION PERMIT / EXISTING SYSTEM

PIN # 4677009298

APPLICANT/OWNER: Debbie Brannon APPLICANT ADDRESS: 132 Sherwood Pines Dr.

SITE ADDRESS: 132 Sherwood Pines Dr. Mooresville, NC PHONE: 704-894-2227 ALT. PHONE 704-663-1877

SITE DIRECTIONS: NC 152 → R on Linwood Ave → L on Sherwood Pines Dr → lot on R SAP CONTROLLED: ☐ YES ☐ NO

SUBDIVISION: — SECTION: — LOT # — LOT AREA: .65ac DESIGN FLOW: existing L.T.A.R.: —

Septic Tank 1000 (gal) STB [illegible] Date 1060
Pump Tank (gal) PT Date
Pump Make Model Serial #
Nitrification Fields # Lines Lineal ft
Trench Width Trench Bottom Depth (low side) Gravel Depth

☐ New System ☑ Repair ☐ Expansion System Type: I II III IV V VI
System Description:
Repair System Description: tank replacement
Maintenance Agreement Required: ☐ YES ☑ NO
☑ GRAVITY ☐ PRESSURE

☑ Residence No. Bedrooms ex.
☐ Business No. Persons ex.
☐ Other No. Employees
☐ Slab ☑ Crawl Space
☐ Basement w/plumbing ☐ Basement w/o plumbing


Water Supply: ☑ Private ☐ Public ☐ Community

EXISTING

Comments / Conditions: Pump, crush, & fill existing tank. New tank must maintain a minimum of 5' from house.

Installed as Shown
Locator 1060 Tank used.

INITIAL SITE SKETCH

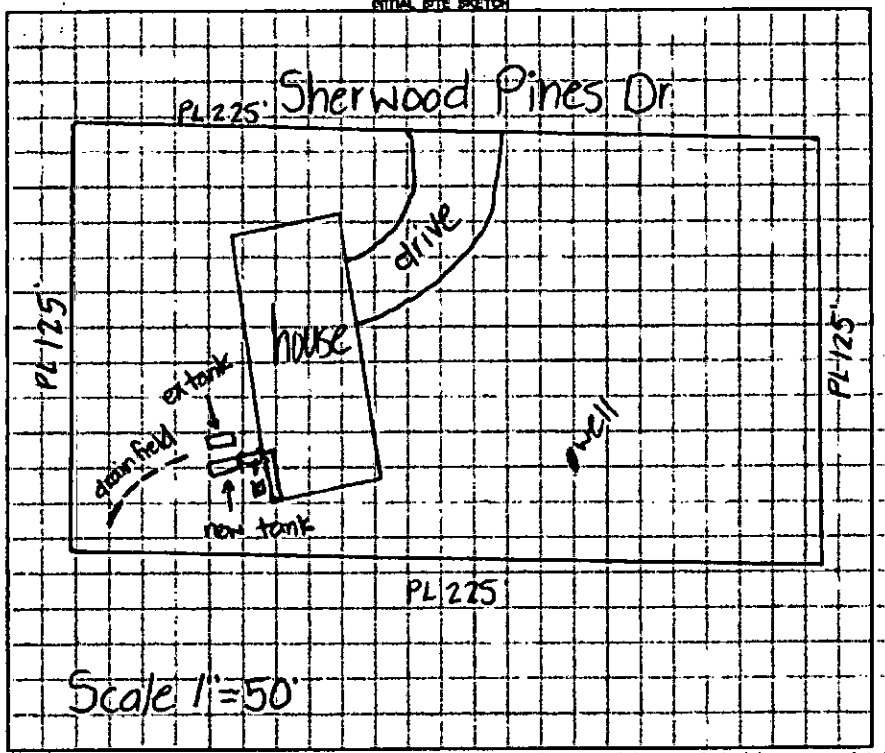

AS BUILT SKETCH

Authorization to Construct

Client gets attached photo copy

Permit can be suspended or revoked if any false information is supplied toward securing the permit / any unauthorized changes are made to the site / any unauthorized changes are made in the installation of the system. CONTACT A LOCATOR SERVICE PRIOR TO ANY EXCAVATION

☐ IMPROVEMENT PERMIT *with plat valid without expiration.* ☑ IMPROVEMENT PERMIT *with site plan valid for 60 mos.* ☑ AUTHORIZATION TO CONSTRUCT *valid for period equal to IMPROVEMENT PERMIT--not to exceed 60 mo.*

Owner / Applicant Signature: Debra D. Brannon Date: 9-21-18 Installed by: Mossy Septic

IMPROVEMENT PERMIT by: [signature] Date: 9-21-18 OPERATION PERMIT by: [signature] Date: 9/26/2018

AUTHORIZATION TO CONSTRUCT by: [signature] Date: 9-21-18 Existing System Inspected by: Date:

FOR SEPTIC FINAL INSPECTION: CALL 704-664-3703 between 8am-9am the day the inspection is needed. Be sure to speak with an inpsector to confirm your inspection time.

Emergency - Have a 7'x4' sink hole

238493

IREDELL COUNTY DEPARTMENT of ENVIRONMENTAL HEALTH

APPLICATION FORM

Application For: ( ) New Well Permit ( ) Well Repair Permit ( ) Well Abandonment
( ) Septic Improvement Permit ( ) Authorization to Construct ( ) Existing System Inspection (✓) Septic System Repair

THE ABOVE PERMIT DOCUMENTS WILL BECOME INVALID IF INFORMATION PROVIDED ON THIS APPLICATION IS FALSIFIED OR CHANGED, OR IF THE SITE IS ALTERED. THE IMPROVEMENT PERMIT IS VALID FOR EITHER 60 MONTHS OR WITHOUT EXPIRATION DEPENDING UPON DOCUMENTATION SUBMITTED. APPLICATION WITH SITE PLAN 60 MONTHS, APPLICATION WITH COMPLETE, SCALED PLAT WITHOUT EXPIRATION. SEE 15A NCAC 18A .1937(f) FOR DETAILS.

Page 2: *Site Plan Worksheet* form MUST accompany this application

The following optional attachments may also be submitted: ( ) Survey Plat, scaled no more than 1 inch = 60 feet
Place an (X) beside whichever is submitted if applicable ( ) Custom Site Plan, scaled no more than 1 inch = 60 feet

Applicant Information: (PRINT CLEARLY)

Applicant Name: Debbie Brannon Address: 132 Sherwood Pines Dr, Mooresville NC Zip: 28115
Applicant Email: debrannon@davidson.edu Phone: 704-894-2227-WK Alt. Phone: 704-663-1877-home
Owner Name: Debbie Brannon Address: — Daughter Cell - 704-490-3371 Zip: —
Owner Email: Same Phone: — Alt. Phone: —

Property Information:

Street Address: 132 Sherwood Pines Dr, Mooresville, NC 28115

Subdivision Name: — Section/Phase: _____ Lot Number: _____

Driving Directions: Turn right at Jay Bell Cafe (End of N main st), on to Linwood Rd. - 1½ miles on the left - Brick Ranch style - off the road - Visible from Linwood - dirt Rd.

Site Development Information: *(check or complete ALL that apply*

CHECK FOUNDATION TYPE

( ) New Single Family Residence Maximum Number of Bedrooms: 3 (✓) Crawl Space Foundation
( ) New Multi-Family Residence Maximum Number of Occupants: 4 ( ) Concrete Slab Foundation
( ) Accessory Building ( ) Swimming Pool ( ) Basement with Plumbing
( ) Bedroom(s) Addition ( ) Other Addition/Structure: _____ ( ) Basement without Plumbing
(✓) Repair to failing septic system ✓ Tank ✓ Drain lines Describe Problem: - Caved in - new all need
Non-Residential Site Development: Type of Business: _____
Square Footage of Building: ~~_____~~ Max. Number of Employees: ____ Max. Number of Seats/Beds/Other: ____

Water Supply: ( ) Replacement Well – Reason: _____
( ) Multi-connection Well Number of Houses: _____ Number of Persons: _____

( ) New Well ( ) Existing Well ( ) Community Well ( ) City Water ( ) Other Public Water

Desired Septic System Type: *(you may rank in order of preference)* Year existing system installed: 1973
( ) No Preference ( ) Alternative (✓) Conventional ( ) Innovative ( ) Modified Conventional ( ) Other: _____

Please answer the following to the best of your ability:
( ) Yes (✓) No Does the site contain any jurisdictional wetlands?
( ) Yes (✓) No Is any non-domestic sewage (i.e. industrial) to be generated?
( ) Yes (✓) No Is the site subject to approval by any other public agency?

I have read this application and certify that the information provided herein is true, complete, and correct. Authorized county and state officials are granted right of entry to conduct necessary inspections to determine compliance with applicable laws and rules. I understand that I am solely responsible for the proper identification and labeling of all property lines and corners and making the site accessible so that a complete site evaluation can be performed.

Signature: Debra D. Brannon 9-20-18
Property owner or owner's legal representative signature (SIGNATURE REQUIRED) DATE

IREDELL COUNTY DEPARTMENT OF ENVIRONMENTAL HEALTH

DOCUMENTATION TO AUTHORIZE AN OWNER'S LEGAL REPRESENTATIVE

(Check and sign only ONE of the options below)

☑ 1. * APPLICANT AND OWNER ARE THE SAME. * (Sign here) Melissa D. Brannon

Applications for permits require the "signature of the owner or owner's legal representative" (15A NCAC 18A .1937). If the owner does not sign the application himself or herself, they can submit any one of the following documents to designate their legal representative: *Power of Attorney; Real Estate Contract; Estate executor; Bankruptcy trustee; Court ordered guardianship*

In the absence of the above documentation, the property owner may provide the local health department with documentation that designates a legal representative. A property owner may:

Complete this form to document his or her legal representative, or provide his or her own form that contains the information in this form. If there are multiple property owners, then all property owners must sign the form that designates a legal representative.

By signing a form that designates a legal representative for purposes of 15A NCAC 18A .1937, the property owner authorizes that representative to act on their behalf in matters pertaining to the application and permitting process, including signing or receiving any application, document or permit. The owner retains full responsibility to meet all permit conditions specified by the local health department.

☐ 2. I, _____, am the legal owner(s) of the property located at _____, identified as PIN (Parcel Identification Number) _____, located in Iredell County, North Carolina.

I do hereby authorize (print legal representative/company name)

_____ _____, to act as an agent on my behalf in applying for/signing/obtaining any of the documents described below:

- Application for Improvement Permit (IP)/ Authorization to Construct (AC)
- Improvement Permit (IP)/ Authorization to Construct (AC)
- Application for soil-site evaluation (new/repair)
- Application/permit for private drinking water well/well abandonment
- Application for Compliance Inspection

I agree to abide by all decisions and/or conditions between the legal representative acting on my behalf and the Iredell County Department of Public Health, Environmental Health Division.

_____ _____

Signature of Owner(s) Date

Mooresville - Environmental Health
ronda.hart@co.iredell.nc.us
Fax: 704-662-3239
610 E. Center Avenue, Mooresville, NC 28115

Statesville - Environmental Health
adrienne.shea@co.iredell.nc.us
Fax: 704-871-3483
349 N. Center Street, Statesville, NC 28677