4077-07-3130 11:00

IREDELL COUNTY HEALTH DEPARTMENT

STATESVILLE 704-878-5305 MOORESVILLE 704-664-5281

IMPROVEMENT PERMIT / CERTIFICATE OF COMPLETION / OPERATION PERMIT / EXISTING SYSTEM INSPECTION

PROPERTY DESCRIPTION NO. No DATE 10/5/99 TAX MAP NO. NA Watershed: ☐ Yes ☒ No

OWNER OR CONTRACTOR BOBBY WATTS PHONE: Business 574-2220 Home 847-2327

ADDRESS N. MAIN ST. MOORESVILLE, NC 28115

LOCATION N. MAIN ON (L) 2ND HOUSE PAST NEAL RANCH RD.

SUBDIVISION N/A BLOCK / SECTION ____ LOT ____ LOT AREA ____ SITE CLASS. ____ DESIGN FLOW ____ L.T.A.R. ____

Septic Tank: 1000 Gallons; STB 312 Date 4/20/99
Pump Tank: ____ Gallons; PT ____ Date ____
Pump Make: ____ Model ____ Serial No. ____
Nitrification Field: No Fields No Square Feet ____ Linear Feet ____
No Lines NO Trench Width ____ Max Trench Bottom Depth ____ Gravel Depth ____

☐ New System ☒ Repair System Type: I, II, III, IV, V, VI
System Description: REPLACE S/T
Repair System Description: "
Maintenance Agreement Required: ☐ Yes ☒ No


☒ House/Mod. Home No. Bedrooms 3
☐ Mobile Home No. Bathrooms 1
☐ Business No. Employees ____
☐ Other ____
☐ Slab ☐ Crawl Space ☐ Basement w/plumbing ☐ Basement wo/plumbing

Water Supply:
☒ Individual
☐ Community
☐ Public

Comments: Replace old septic tank with new 99 standard tank and reconnect to existing drainfield.

Comments: Had to install New Supply line From Septic tank to D-Box & had to set New D-Box

INITIAL SITE SKETCH

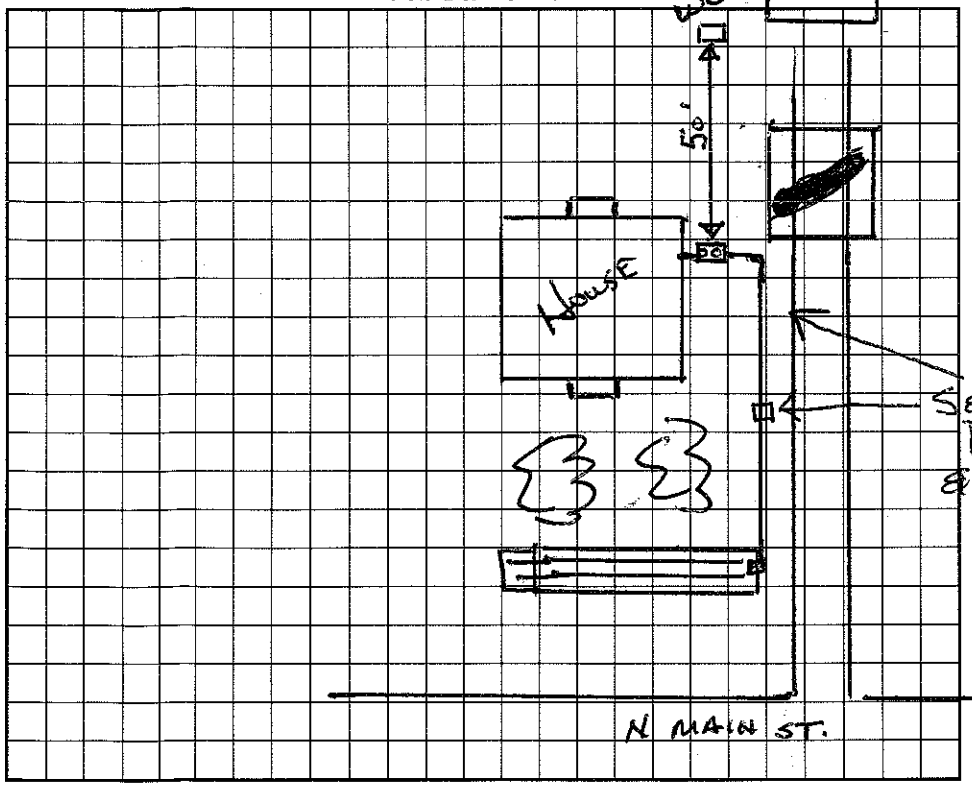

AS BUILT SKETCH

I understand that this permit can be suspended or revoked if any false information is supplied toward securing the permit/any unauthorized changes are made to the site/any unauthorized changes are made in the installation of the system. Improvement Permit is valid for 60 months from date of issuance.

Signed: Bobbie W. Watts 10/5/99

Improvement Permit by: Wesley Sparks RS date 10/5/99

Existing System Inspection by: Wesley Sparks RS date 10/5/99

Installed by: F.J. Ervin

Certificate of Completion by: Marian H. Dotson date 10/29/99

Operation Permit by: Marian H. Dotson date 10/29/99

HEALTH DEPT. COPY: WHITE INSPECTION COPY (FINAL): GREEN OWNER COPY (FINAL): YELLOW INSPECTION COPY (INITIAL): PINK OWNER COPY (INITIAL): GOLD