IREDELL COUNTY HEALTH DEPARTMENT

STATESVILLE 704-878-5305 MOORESVILLE 704-664-5281

IMPROVEMENT PERMIT / AUTHORIZATION TO CONSTRUCT / OPERATION PERMIT / EXISTING SYSTEM INSPECTION

PERMIT# 7515 PIN# 4677016147 Cell 4677.11 0187 DATE 7-2-2001

OWNER OR CONTRACTOR James & Leslie Keaton PHONE: Business 236-2040 Home 663-6722

ADDRESS

LOCATION Hwy 152 (Main St) TR. Linwood ~ 1 mile on left just past Linwood Farms on left

SUBDIVISION BLOCK / SECTION LOT LOT AREA SITE CLASS. RS DESIGN FLOW 480 gpd L.T.A.R. 1.3

Septic Tank: 1000 Gallons: STB 794 Date 1-29-01
Pump Tank: 1000 Gallons: PT 27 Date 4-10-01
Pump Make: Model Serial No.
Nitrification Field: No Fields 1 Square Feet 1596 Linear Feet 532
No Lines 4 @ 133' Trench Width 36" Max Trench Bottom Depth 28 Gravel Depth 12"

☐ New System ☐ Repair System Type: I, II, III, IV, V, VI
System Description: Pump (pm) Conventional
Repair System Description: Pump - Innovative
Maintenance Agreement Required: ☐ Yes ☐ No


☒ House/Mod. Home No. Bedrooms 4
☐ Mobile Home No. Bathrooms 3.5
☐ Business No. Employees
☐ Other
☐ Slab ☐ Crawl Space ☐ Basement w/plumbing ☐ Basement wo/plumbing

Water Supply:
☒ Individual
☐ Public
☐ Community


Comments:/Conditions:

Comments:/Conditions:

INITIAL SITE SKETCH

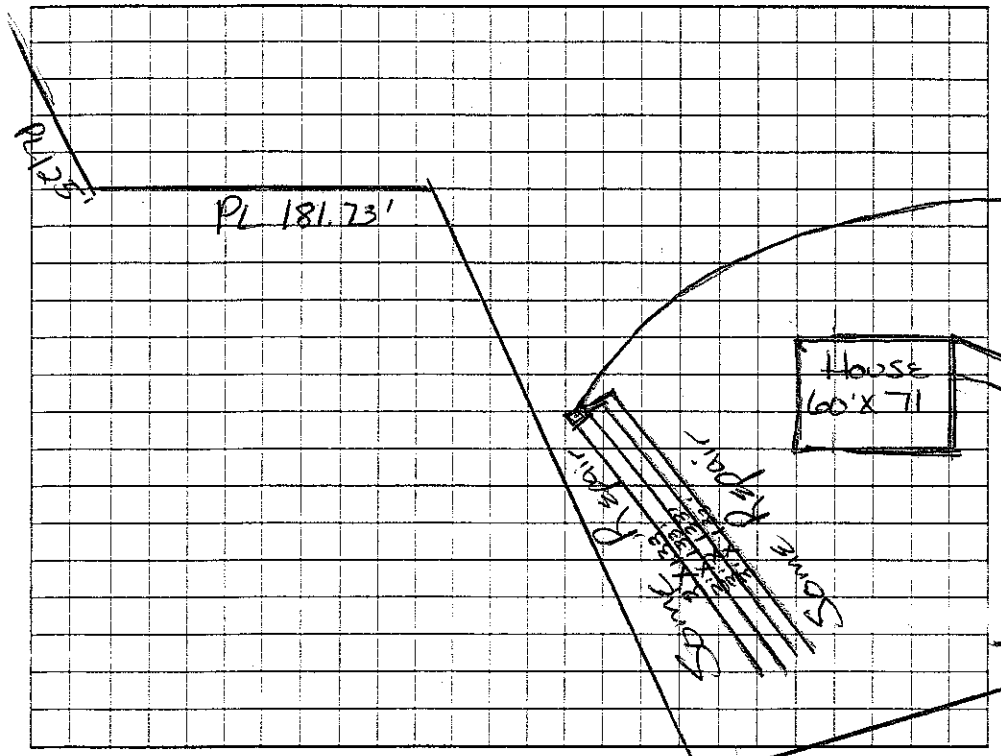

AS BUILT SKETCH

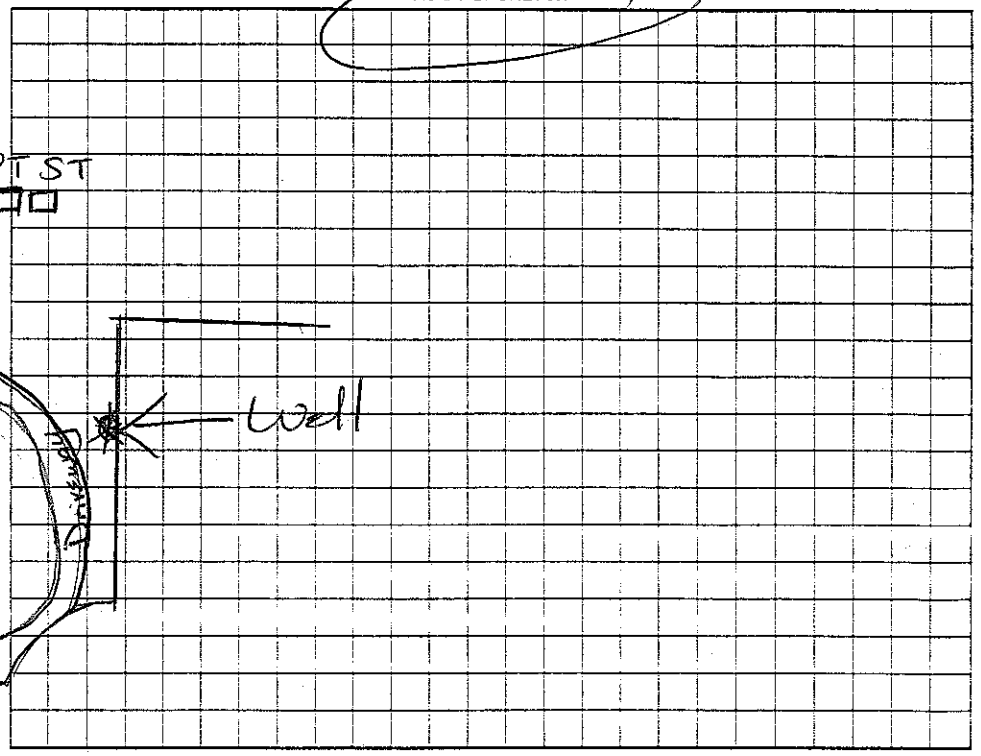

Permit can be suspended or revoked if any false information is supplied toward securing the permit/any unauthorized changes are made to the site/any unauthorized changes are made in the installation of the system. Improvement Permit with plat valid without expiration. Improvement Permit with site plan valid for sixty months. Authorization to Construct is valid for a period equal to that of Improvement Permit – not to exceed sixty months.

Signed: date

Improvement Permit by: date

Authorization to Construct by: date

Installed by: W. Orbinson RS.

Operation Permit by: Maria H. Dotson date 7/2/2001

Existing System Inspection by: date

HEALTH DEPT. COPY: WHITE OWNER COPY (FINAL): YELLOW OWNER COPY (INITIAL): PINK