4677156289 (2:00)

IREDELL COUNTY HEALTH DEPARTMENT

STATESVILLE 704-878-5305 MOORESVILLE 704-664-5281

IMPROVEMENT PERMIT / CERTIFICATE OF COMPLETION / OPERATION PERMIT / EXISTING SYSTEM INSPECTION

PROPERTY DESCRIPTION NO. 4485 - MOORESVILLE DATE 3/18/97 TAX MAP NO. 1N-A-32 Watershed: ☑ Yes ☐ No

OWNER OR CONTRACTOR ~~EXCEL~~ LORI SMALL PHONE: Business _____ Home 663-5897

ADDRESS 1035 DAVIS ST MOORESVILLE NC 28115

LOCATION N MAIN ST - TR AZALEA RD - AT END

SUBDIVISION — BLOCK / SECTION — LOT 32 LOT AREA 5.52 AC SITE CLASS. PS DESIGN FLOW 360 L.T.A.R. _____

Septic Tank: EXISTING Gallons; STB _____ Date _____

Pump Tank: _____ Gallons; PT _____ Date _____

Pump Make: _____ Model _____ Serial No. _____

Nitrification Field: No Fields 1 Square Feet 300 Linear Feet 100

No Lines 2@50 Trench Width 36" Max Trench Bottom Depth 36" Gravel Depth 12"

☑ New System ☐ Repair System Type: I (II) III, IV, V, VI

System Description: GRAVITY CONVENTIONAL

Repair System Description: SAME

Maintenance Agreement Required: ☐ Yes ☑ No

☐ House/Mod. Home ☑ Mobile Home ☐ Business ☐ Other

No. Bedrooms 3 No. Bathrooms 2 No. Employees ____


☐ Slab ☑ Crawl Space ☐ Basement w/plumbing ☐ Basement wo/plumbing

Water Supply: ☑ Individual ☐ Community ☐ Public


Comments:

Comments:

INITIAL SITE SKETCH

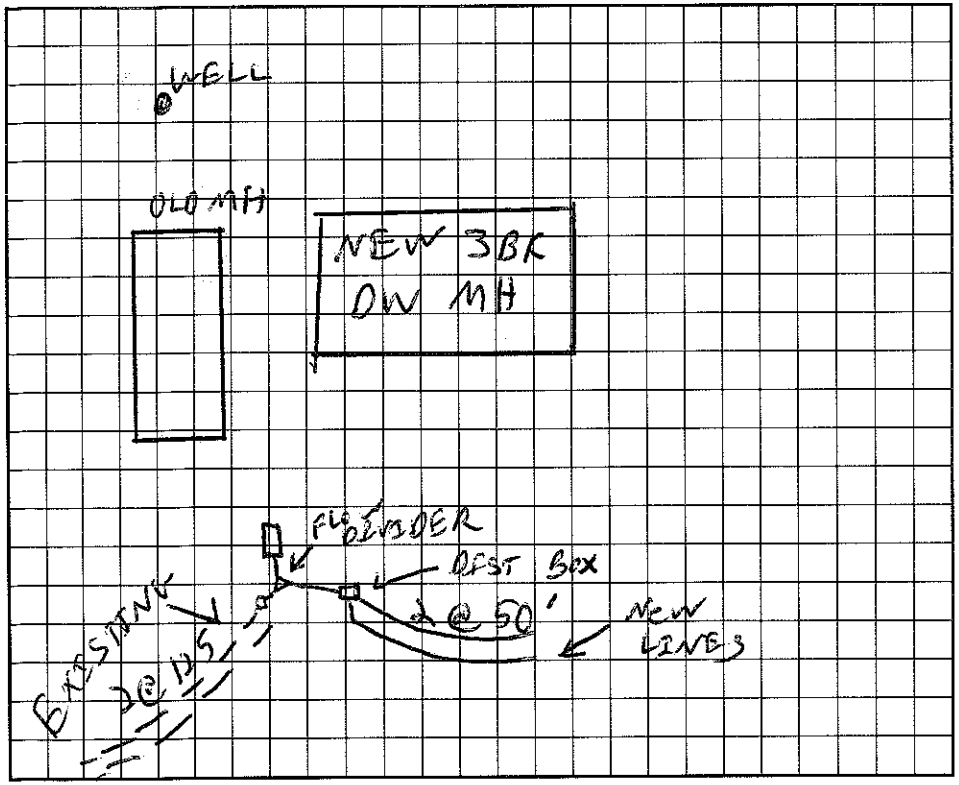

AS BUILT SKETCH

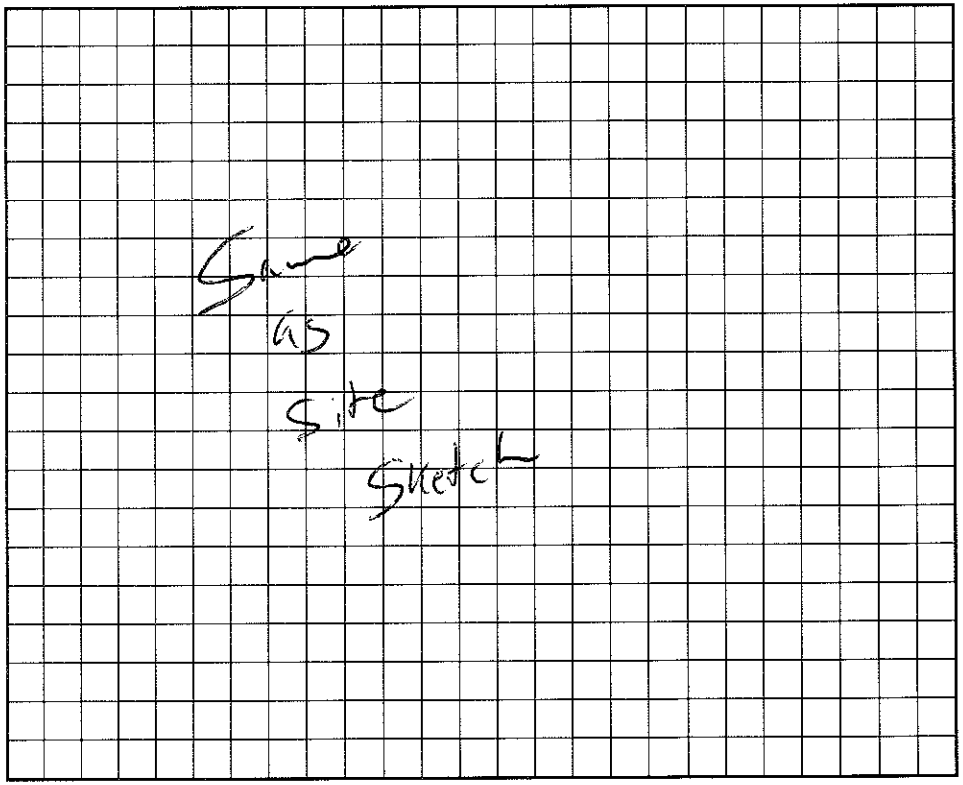

I understand that this permit can be suspended or revoked if any false information is supplied toward securing the permit/any unauthorized changes are made to the site/any unauthorized changes are made in the installation of the system. Improvement Permit is valid for 60 months from date of issuance.

Signed: Laurie Small

Improvement Permit by: C. Rob Zoo date 3/17/97

Existing System Inspection by: C. Rob Green date 3/17/97

Installed by: WARD'S BACKHOE & GRADING

Certificate of Completion by: _____ date _____

Operation Permit by: C. Rob Green date _____

HEALTH DEPT. COPY: WHITE INSPECTION COPY (FINAL): GREEN OWNER COPY (FINAL): YELLOW INSPECTION COPY (INITIAL): PINK OWNER COPY (INITIAL): GOLD