4677167435

IREDELL COUNTY HEALTH DEPARTMENT

STATESVILLE 704-878-5305 MOORESVILLE 704-664-5281

IMPROVEMENT PERMIT / CERTIFICATE OF COMPLETION / OPERATION PERMIT / EXISTING SYSTEM INSPECTION

PROPERTY DESCRIPTION NO. Repair DATE 10/5/94 TAX MAP NO. N/A Watershed: ☐ Yes ☑ No

OWNER OR CONTRACTOR Nick Dobson PHONE: Business _____ Home 663-2520

ADDRESS 145 Azalea Rd. Mooresville

LOCATION 152E (R) on Azalea to last brick on (L) Lakewood II 145 on mailbox

SUBDIVISION N/A BLOCK / SECTION _____ LOT _____ LOT AREA _____ SITE CLASS. _____ DESIGN FLOW _____ L.T.A.R. _____

Septic Tank: EXISTING Gallons; STB _____ Date _____

Pump Tank: _____ Gallons; PT _____ Date _____

Pump Make: _____ Model _____ Serial No. _____

Nitrification Field: No Fields 1 Square Feet 600 Linear Feet 200

No Lines 2 Trench Width 36" Max Trench Bottom Depth 36" Gravel Depth _____

☐ New System ☑ Repair System Type: I, ☑ II, III, IV, V, VI

System Description: CONV - DIST BOX

Repair System Description: _____

Maintenance Agreement Required: ☐ Yes ☑ No

☑ House/Mod. Home No. Bedrooms 3

☐ Mobile Home No. Bathrooms 2

☐ Business No. Employees _____

☐ Other _____


☐ Slab ☐ Crawl Space ☐ Basement w/plumbing ☐ Basement wo/plumbing

Water Supply: ☑ Individual ☐ Community ☐ Public

Comments: Drains will need to be repaired after installation.

Comments:

INITIAL SITE SKETCH

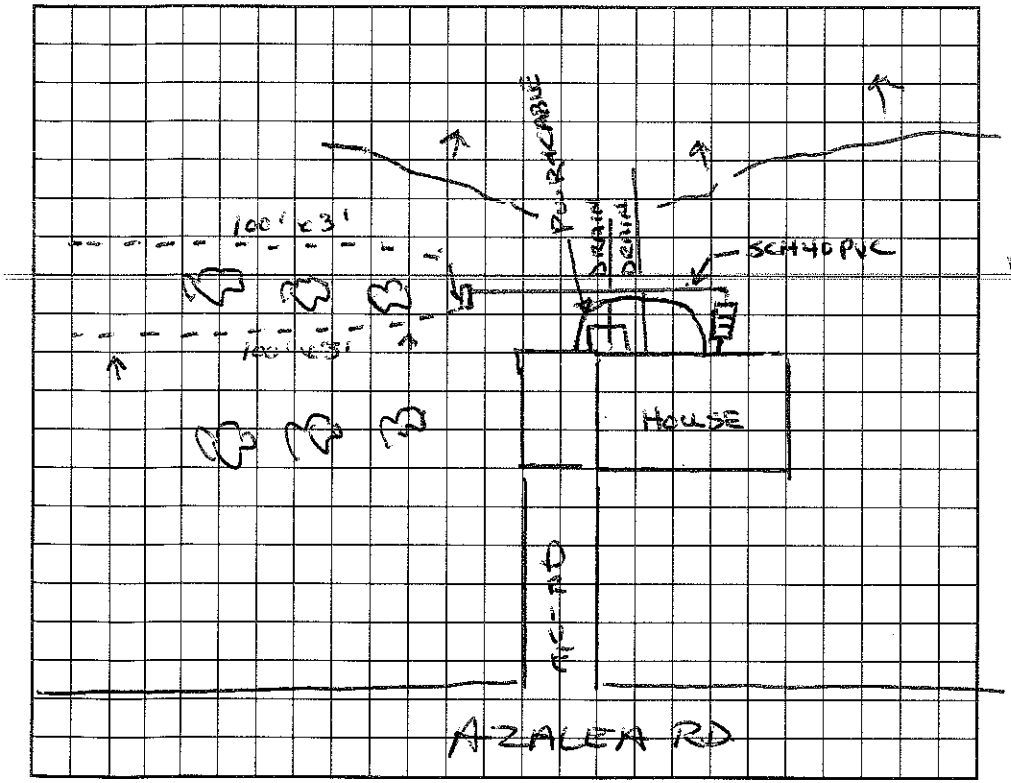

AS BUILT SKETCH

I understand that this permit can be suspended or revoked if any false information is supplied toward securing the permit/any unauthorized changes are made to the site/any unauthorized changes are made in the installation of the system. Improvement Permit is valid for 60 months from date of issuance.

Signed: _____

Improvement Permit by: Wesley Sparks RS. date 10/5/94

Existing System Inspection by: _____ date _____

Installed by: Larry Beam

Certificate of Completion by: Wesley Sparks RS. date 10/10/94

Operation Permit by: _____ date _____

HEALTH DEPT. COPY: WHITE INSPECTION COPY (FINAL): GREEN OWNER COPY (FINAL): YELLOW INSPECTION COPY (INITIAL): PINK OWNER COPY (INITIAL): GOLD