# IREDELL COUNTY HEALTH DEPARTMENT

STATESVILLE 704-878-5305 MOORESVILLE 704-664-5281

## IMPROVEMENT PERMIT / CERTIFICATE OF COMPLETION / OPERATION PERMIT / EXISTING SYSTEM INSPECTION

PROPERTY DESCRIPTION NO. 1459 DATE 5/26/94 TAX MAP NO. 1N9 B 16 Watershed: ☑ Yes ☐ No

OWNER OR CONTRACTOR LARRY MORROW PHONE: Business 467-24-7665 Home

ADDRESS PO BOX 1317 ~~MOORESVILLE, NC. 28115~~ DAVIDSON, NC. 28036

LOCATION PICKWICK DRIVE, 152 (MAIN ST) TR ON PICKWICK, STRAIGHT TO LOT ON (R) BEFORE CUL DE SAC

SUBDIVISION PICKWICK BLOCK / SECTION LOT 16 LOT AREA .921 SITE CLASS. P DESIGN FLOW 360 L.T.A.R. .25-.3

Septic Tank: 1000 Gallons; STB 794 Date 11/19/94

Pump Tank: Gallons; PT Date

Pump Make: Model Serial No.

Nitrification Field: No Fields 1 Square Feet 1200 Linear Feet 400

No Lines 3 or 4 Trench Width 3' Max Trench Bottom Depth 32" Gravel Depth 12"

☑ New System ☐ Repair System Type: I, (II) III, IV, V, VI

System Description: CONV. - DIST BOX

Repair System Description:

Maintenance Agreement Required: ☐ Yes ☐ No

☑ House/Mod. Home No. Bedrooms 3

☐ Mobile Home No. Bathrooms 2

☐ Business No. Employees

☐ Other


☐ Slab ☑ Crawl Space ☐ Basement w/plumbing ☐ Basement wo/plumbing

Water Supply: ☑ Individual ☐ Community ☐ Public

Comments:

Comments: installed as shown.

**INITIAL SITE SKETCH**

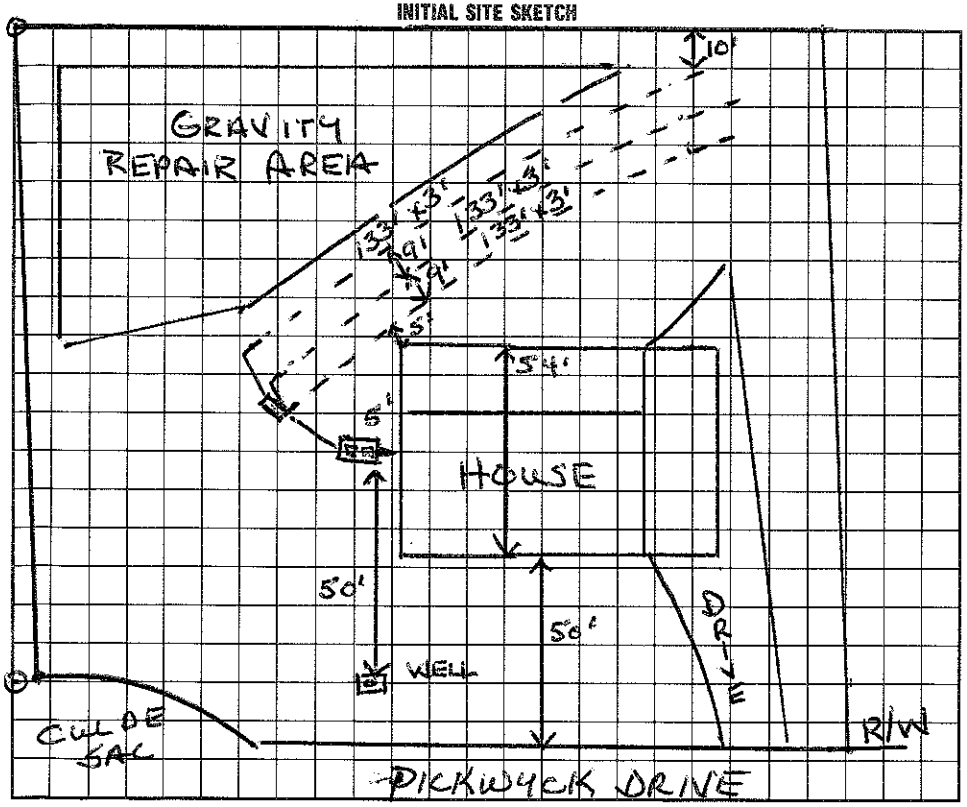


**AS BUILT SKETCH**

I understand that this permit can be suspended or revoked if any false information is supplied toward securing the permit/any unauthorized changes are made to the site/any unauthorized changes are made in the installation of the system. Improvement Permit is valid for 60 months from date of issuance.

Signed:

Improvement Permit by: Wesley Sparks RS. date 5/26/94

Existing System Inspection by: date

Installed by: Lenny Brown

Certificate of Completion by: Wesley Sparks RS. date 2/27/95

Operation Permit by: date

HEALTH DEPT. COPY: WHITE INSPECTION COPY (FINAL): GREEN OWNER COPY (FINAL): YELLOW INSPECTION COPY (INITIAL): PINK OWNER COPY (INITIAL): GOLD