IREDELL COUNTY HEALTH DEPARTMENT

STATESVILLE 704-878-5305 MOORESVILLE 704-664-5281

IMPROVEMENT PERMIT / AUTHORIZATION TO CONSTRUCT / OPERATION PERMIT / EXISTING SYSTEM INSPECTION

PERMIT# 151989 PIN# 4677 27 8484 DATE 8/11/08

OWNER OR APPLICANT Curtis Miller PHONE: Business 704-506-5755 Home

ADDRESS 121 Pickwyck Dr. Mooresville, NC. 28115

LOCATION 121 Pickwyck Dr.

SUBDIVISION Pickwyck Village BLOCK / SECTION 1 LOT 4 LOT AREA .58 SITE CLASS. P DESIGN FLOW 360 L.T.A.R.

Septic Tank: EXISTING Gallons: STB Date

Pump Tank: Gallons: PT Date

Pump Make: Model Serial No.

Nitrification Field: No Fields Square Feet Linear Feet 300

No Lines 4 Trench Width 3 Max Trench Bottom Depth 3 Gravel Depth

☐ New System ☐ Repair ☐ Expansion System Type: I (II) III IV V VI

System Description: EXISTING SYSTEM

Repair System Description:

Maintenance Agreement Required: ☐ Yes ☒ No

☒ House/Mod. Home No. Bedrooms 3

☐ Mobile Home No. Persons

☐ Business No. Employees

☐ Other


Water Supply: ☒ Individual ☐ Public ☐ Community

☒ Gravity ☐ Pressure ☐ Slab ☒ Crawl Space ☐ Basement w/plumbing ☐ Basement wo/plumbing

Comments/Conditions: (1) Drainfield should not be covered by any concrete or asphalt surfaces. (2) Should repair be necessary several times & the right side of drive will be in jeopardy. (3) Dist Box is not accessible. INITIAL SITE SKETCH + Septic.

Comments/Conditions:

AS BUILT SKETCH

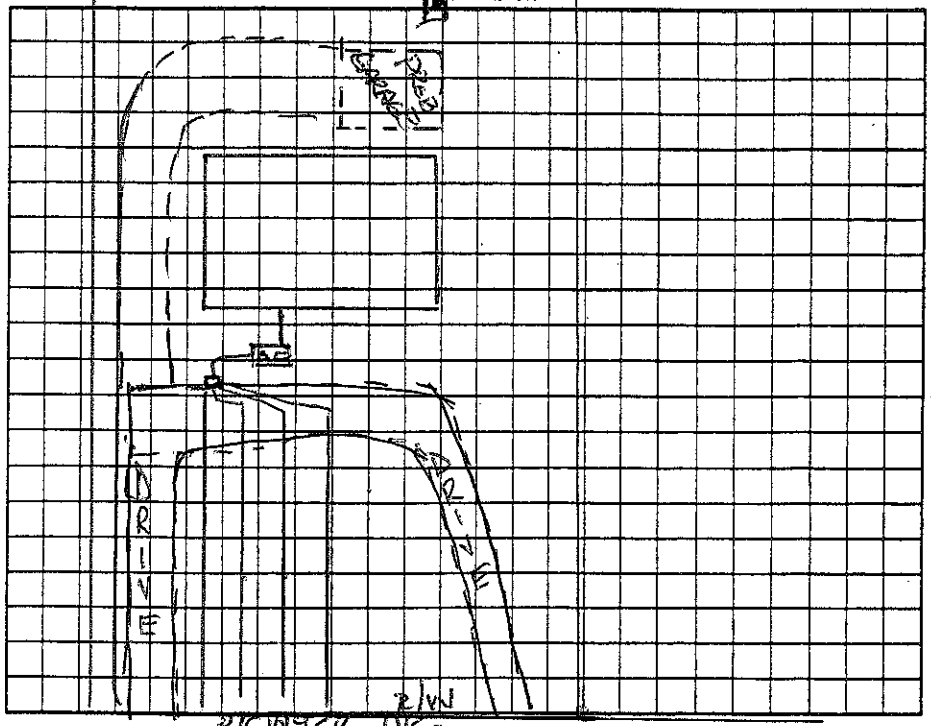

Permit can be suspended or revoked if any false information is supplied toward securing the permit/any unauthorized changes are made to the site/any unauthorized changes are made in the installation of the system. Improvement Permit with plat valid without expiration ☐ Improvement Permit with site plan valid for sixty months ☐ Authorization to Construct is valid for a period equal to that of Improvement Permit – not to exceed sixty months.

Signed: date 6-12-08 Installed by:

Improvement Permit by: date Operation Permit by: date

Authorization to Construct by: date Existing System Inspection by: Wesley Sparks date 8/11/08

HEALTH DEPT. COPY: WHITE OWNER COPY (FINAL): YELLOW OWNER COPY (INITIAL): PINK