IREDELL COUNTY HEALTH DEPARTMENT

STATESVILLE 704-878-5305 MOORESVILLE 704-664-5281

IMPROVEMENT PERMIT / CERTIFICATE OF COMPLETION / OPERATION PERMIT / EXISTING SYSTEM INSPECTION

PROPERTY DESCRIPTION NO. 1447 DATE 7/7/94 TAX MAP NO. 1N-9-A-1 Watershed: ☑ Yes ☐ No

OWNER OR CONTRACTOR Leroy Morrow PHONE: Business 467-27-8794 Home 664-3206 / 533-5760

ADDRESS PO Box 1317 Davidson, NC. 28036

LOCATION 152 (E) TR ON PICKWICK DR. FIRST LOT ON (L) - CORNER LOT

SUBDIVISION PICKWICK VILLAGE BLOCK / SECTION 1 LOT 1 LOT AREA .62AC SITE CLASS. 4 - (P)* DESIGN FLOW _____ L.T.A.R. _____

Septic Tank: 1000 Gallons; STB 794 Date 9/8/94

Pump Tank: _____ Gallons; PT _____ Date _____

Pump Make: _____ Model _____ Serial No. _____

Nitrification Field: No Fields 1 Square Feet 1800 Linear Feet 600

No Lines 7 Trench Width 3' Max Trench Bottom Depth (22")* Gravel Depth 12"

☑ New System ☐ Repair System Type: I, (II) III, IV, V, VI

System Description: ULTRA SHALLOW CONV.

Repair System Description: SAME

Maintenance Agreement Required: ☐ Yes ☐ No

☑ House/Mod. Home No. Bedrooms 3

☐ Mobile Home No. Bathrooms 2

☐ Business No. Employees ____

☐ Other _____


☐ Slab ☑ Crawl Space ☐ Basement w/plumbing ☐ Basement wo/plumbing

Water Supply: ☑ Individual ☐ Community ☐ Public PROPOSED

Comments: *SHALLOW PLACEMENT

Comments: Installed as shown on Imp. Permit

INITIAL SITE SKETCH

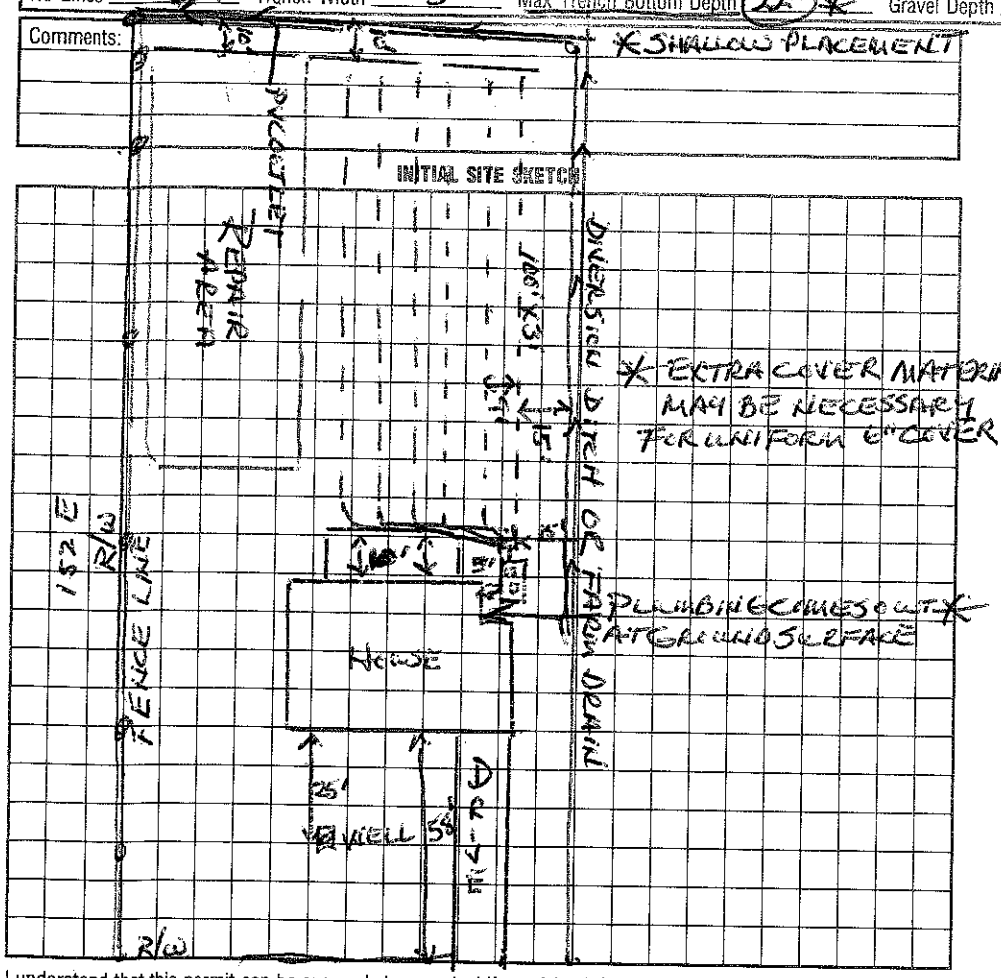

AS BUILT SKETCH

I understand that this permit can be suspended or revoked if any false information is supplied toward securing the permit/any unauthorized changes are made to the site/any unauthorized changes are made in the installation of the system. Improvement Permit is valid for 60 months from date of issuance.

Signed: X _____

Improvement Permit by: Wesley Sparks RS. date 7/7/94

Existing System Inspection by: _____ date _____

Installed by: Leroy Brown

Certificate of Completion by: Wesley Sparks RS date 10/24/94

Operation Permit by: _____ date _____

HEALTH DEPT. COPY: WHITE INSPECTION COPY (FINAL): GREEN OWNER COPY (FINAL): YELLOW INSPECTION COPY (INITIAL): PINK OWNER COPY (INITIAL): GOLD