IREDELL COUNTY HEALTH DEPARTMENT

Statesville Office (704) 878-5305 Mooresville Office (704) 660-3625 PERMIT # Repair

IMPROVEMENT PERMIT / AUTHORIZATION TO CONSTRUCT / OPERATION PERMIT / EXISTING SYSTEM

PIN # 4677 299 717

APPLICANT: Pamela Tulbert APPLICANT ADDRESS: 843 Wiggins Rd Mooresville, NC 28115

SITE ADDRESS: 54 Forest Edge Rd Mooresville, NC PHONE: 704 663-2676 ALT. PHONE: 704 662-2321

SITE DIRECTIONS: Hwy 150 E TL Wiggins Rd. TR 2nd entrance into Woodland Hts, 1st house on

SUBDIVISION: Woodland Heights SECTION: LOT # 11 LOT AREA: DESIGN FLOW: 240gpd L.T.A.R.:

Septic Tank 1000 (gal) STB Date
Pump Tank (gal) PT Date
Pump Make Model Serial #
Nitrification Fields 1 # Lines 2 Linear Ft: 250'
Trench Width 5' Bed. Max. Trench Bottom Depth Gravel Depth 10"

☐ New System ☒ Repair ☐ Expansion System Type: I (II) III IV V VI
System Description: Gravity - Convent. Bed
Repair System Description: Replacing ST only
Maintenance Agreement Required: ☐ YES ☒ NO
☒ GRAVITY ☐ PRESSURE


☒ Residence No. Bedrooms 2
☐ Business No. Persons
☐ Other No. Employees
☐ Slab ☒ Crawl Space
☐ Basement w/plumbing ☐ Basement w/o plumbing

Water Supply: ☒ Private ☐ Public ☐ Community


Comments / Conditions: Must keep new Septic tank at least 5ft from house & PL. Hook onto Existing Drainfield

☒ Divert gutters & Stormwater away from Septic Tank & Drainfield.

INITIAL SITE SKETCH

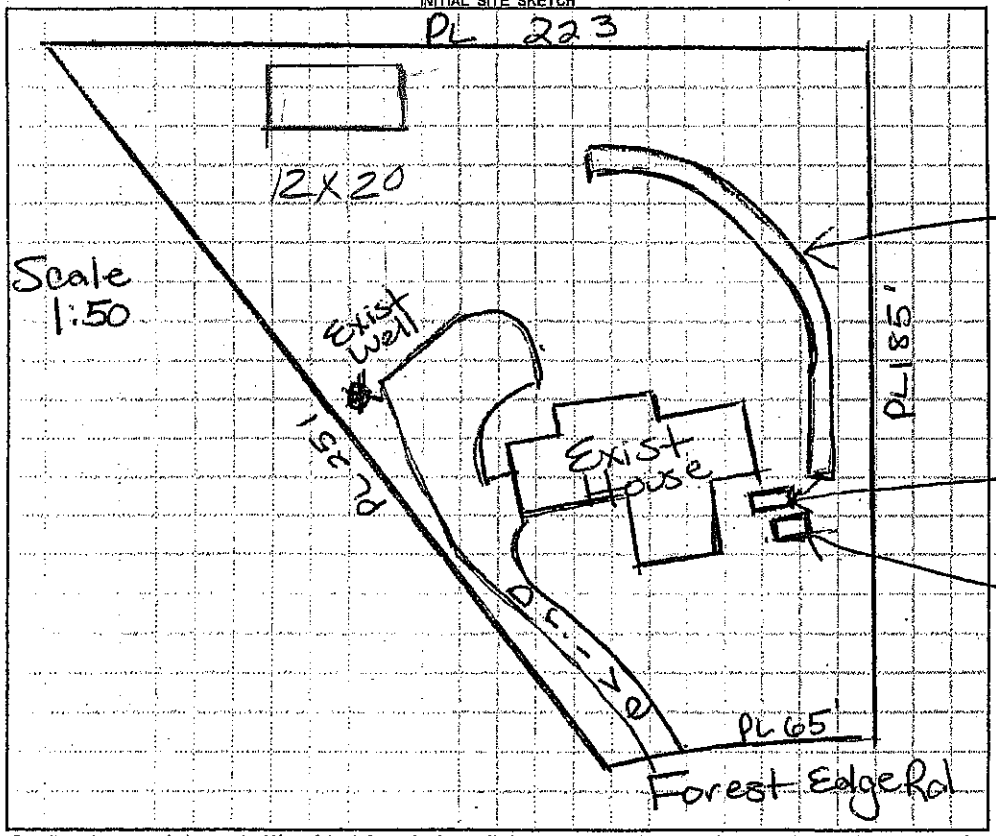

AS BUILT SKETCH

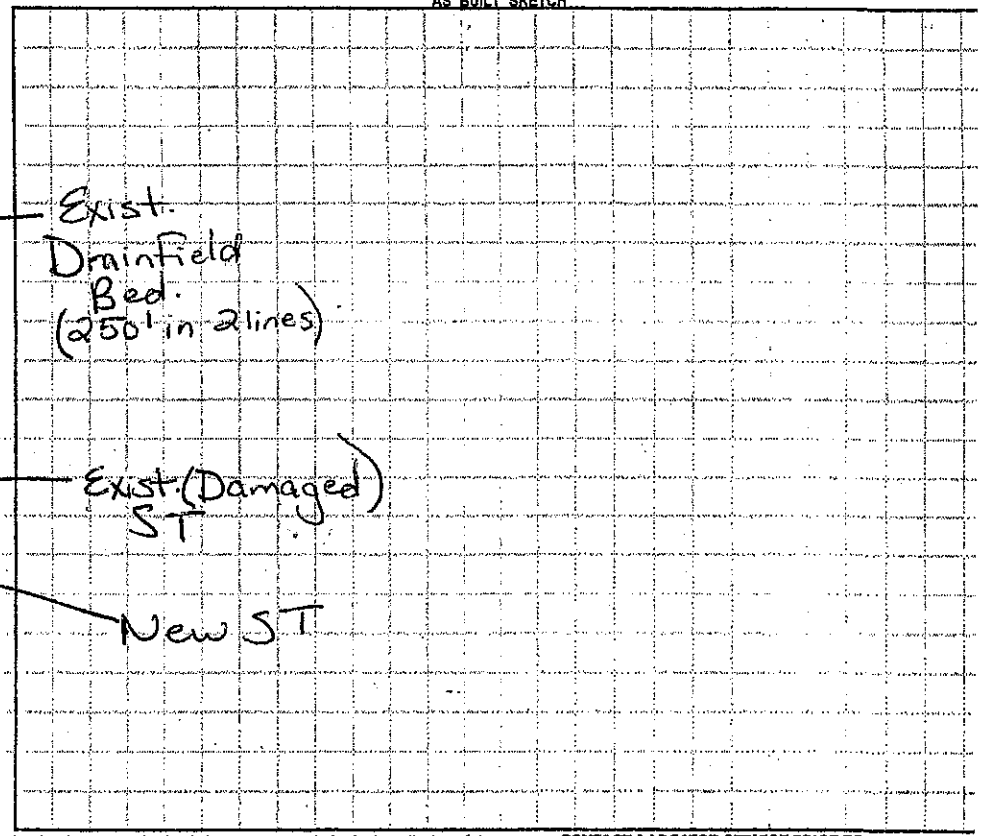

Permit can be suspended or revoked if any false information is supplied toward securing the permit / any unauthorized changes are made to the site / any unauthorized changes are made in the installation of the system. **CONTACT A LOCATOR SERVICE PRIOR TO ANY EXCAVATI**

☐ **IMPROVEMENT PERMIT** *with plat valid without expiration.* ☐ **IMPROVEMENT PERMIT** *with site plan valid for 60 mos.* ☐ **AUTHORIZATION TO CONSTRUCT** *valid for period equal to IMPROVEMENT PERMIT--not to exceed 60 n*

Owner / Applicant Signature: Pamela R. Tulbert Date: 2-11-13 Installed by:

IMPROVEMENT PERMIT by: Maria H. Dotson RS Date: 2/11/13 OPERATION PERMIT by: Date:

AUTHORIZATION TO CONSTRUCT by: Maria H. Dotson RS Date: 2/11/13 Existing System Inspected by: Date:

Health Dept. Copy - WHITE Applicant (Final Approval) - YELLOW Applicant (Conditional Approval) - PINK