IREDELL COUNTY HEALTH DEPARTMENT

STATESVILLE 704-878-5305 MOORESVILLE 704-664-5281

IMPROVEMENT PERMIT / CERTIFICATE OF COMPLETION / OPERATION PERMIT / EXISTING SYSTEM INSPECTION

PROPERTY DESCRIPTION NO. 3476 DATE October 11, '95 TAX MAP NO. 1N12A6 4677-33-4814 Watershed: ☐ Yes ☐ No

OWNER OR CONTRACTOR Kelly Benfield PHONE: Business Home

ADDRESS PO Box 1584, Mooresville

LOCATION 150 E past Carrigan Farms TR Alexander Acres Rd. at end on Right

SUBDIVISION Caudill Estates BLOCK / SECTION LOT 7 LOT AREA ≈1.5Ac SITE CLASS. PS DESIGN FLOW 360gpd L.T.A.R. .3

Septic Tank: 1000 Gallons; STB 794 Date 8/14/95

Pump Tank: Gallons; PT Date

Pump Make: Model Serial No.

Nitrification Field: No Fields 1 Square Feet 1200 Linear Feet 400

No Lines 3@133' Trench Width 36" Max Trench Bottom Depth ≈24" Gravel Depth 12"

☑ New System ☐ Repair System Type: I, II, III, IV, V, VI

System Description: gravity conventional

Repair System Description: pumped conventional

Maintenance Agreement Required: ☐ Yes ☑ No

☐ House/Mod. Home ☑ Mobile Home ☐ Business ☐ Other

No. Bedrooms 2 No. Bathrooms 2 No. Employees


☐ Slab ☑ Crawl Space ☐ Basement w/plumbing ☐ Basement wo/plumbing

Water Supply: ☑ Individual ☐ Community ☐ Public


Comments: System designed for future 3-bedroom dwelling

Comments:

INITIAL SITE SKETCH

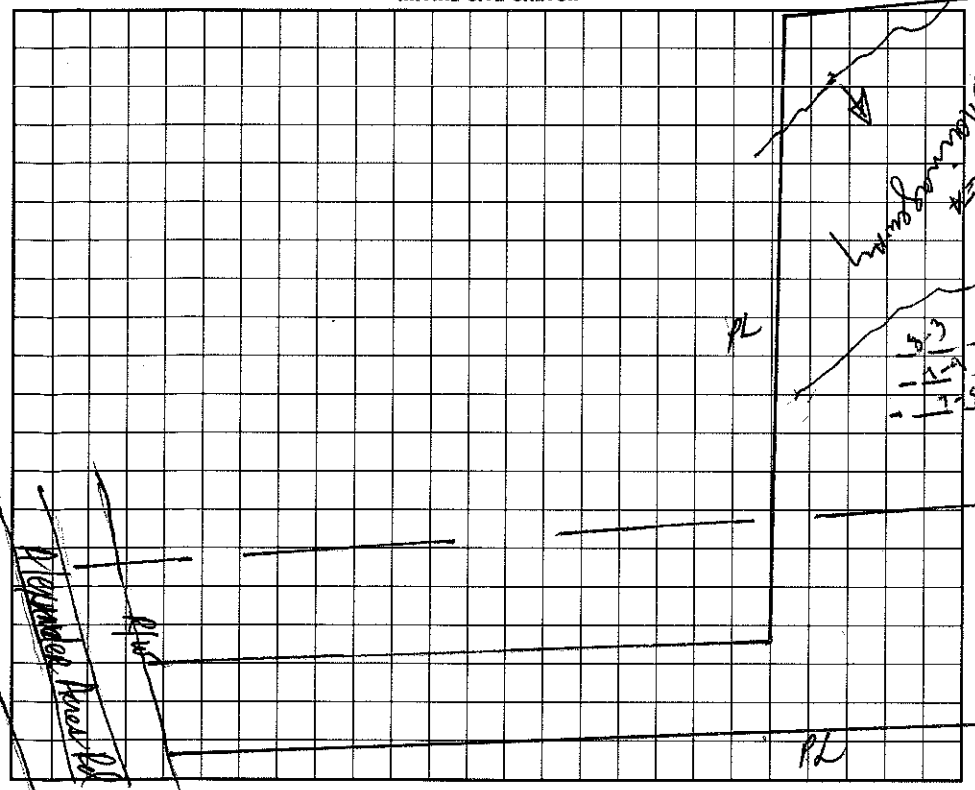

AS BUILT SKETCH

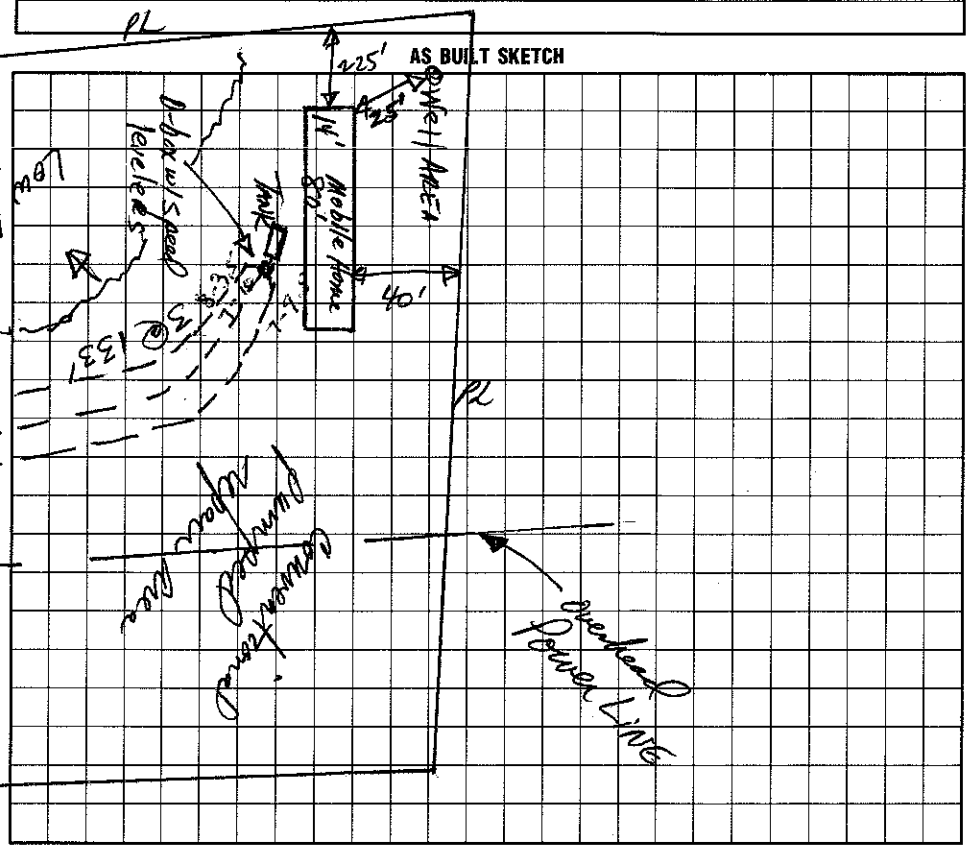

I understand that this permit can be suspended or revoked if any false information is supplied toward securing the permit/any unauthorized changes are made to the site/any unauthorized changes are made in the installation of the system.

Auth to construct is valid for 5 years.

Signed: Kelly Benfield

Improvement Permit by: D K Hanson, RS date 10/11/95

Existing System Inspection by: Auth to construct D K Hanson, RS date 10/11/95

Installed by: Rusty Orbison

Certificate of Completion by: Wesley Sparks RS date 12/1/95

Operation Permit by: Wesley Sparks RS. date 12/1/95

HEALTH DEPT. COPY: WHITE INSPECTION COPY (FINAL): GREEN OWNER COPY (FINAL): YELLOW INSPECTION COPY (INITIAL): PINK OWNER COPY (INITIAL): GOLD