IREDELL COUNTY HEALTH DEPARTMENT

STATESVILLE 704-878-5305 MOORESVILLE 704-664-5281

IMPROVEMENT PERMIT / CERTIFICATE OF COMPLETION / OPERATION PERMIT / EXISTING SYSTEM INSPECTION

PROPERTY DESCRIPTION NO. 1456 DATE August 12, '93 TAX MAP NO. 1N9B13

OWNER OR CONTRACTOR Larry Morrow PHONE: Business 4677-36-0514 Home

ADDRESS

LOCATION 152 E SR Picwyck DR. on left at Cul-de-Sac

SUBDIVISION Picwyck Village BLOCK / SECTION II LOT 13 LOT AREA 40,000 SF SITE CLASS. PS L.T.A.R. .03

Water Supply: ☑ Individual ☐ Community ☐ Public

Septic Tank: 1000 Gallons; STB 358 Date 11/16/93

Pump Tank: Gallons; PT Date

Nitrification Field: No Fields 1 Square Feet 1200 Linear Feet 400

No Lines 3-4 Trench Width 36" Trench Depth 24" Gravel Depth 12"

☑ New System ☐ Repair System Type: I, II, III, IV, V, VI

System Description: gravity conventional

Repair System Description: Same

Maintenance Agreement Required: ☐ Yes ☑ No

☑ House/Mod. Home No. Bedrooms 3

☐ Mobile Home No. Bathrooms 2

☐ Business No. Employees

☐ Other

☐ Slab ☑ Crawl Space ☐ Basement w/plumbing ☐ Basement wo/plumbing

Garbage Disposal: ☑ Yes ☐ No


Auto. Dishwasher: ☑ Yes ☐ No

Auto. Washing Machine: ☑ Yes ☐ No

Other

Comments

INITIAL SITE SKETCH

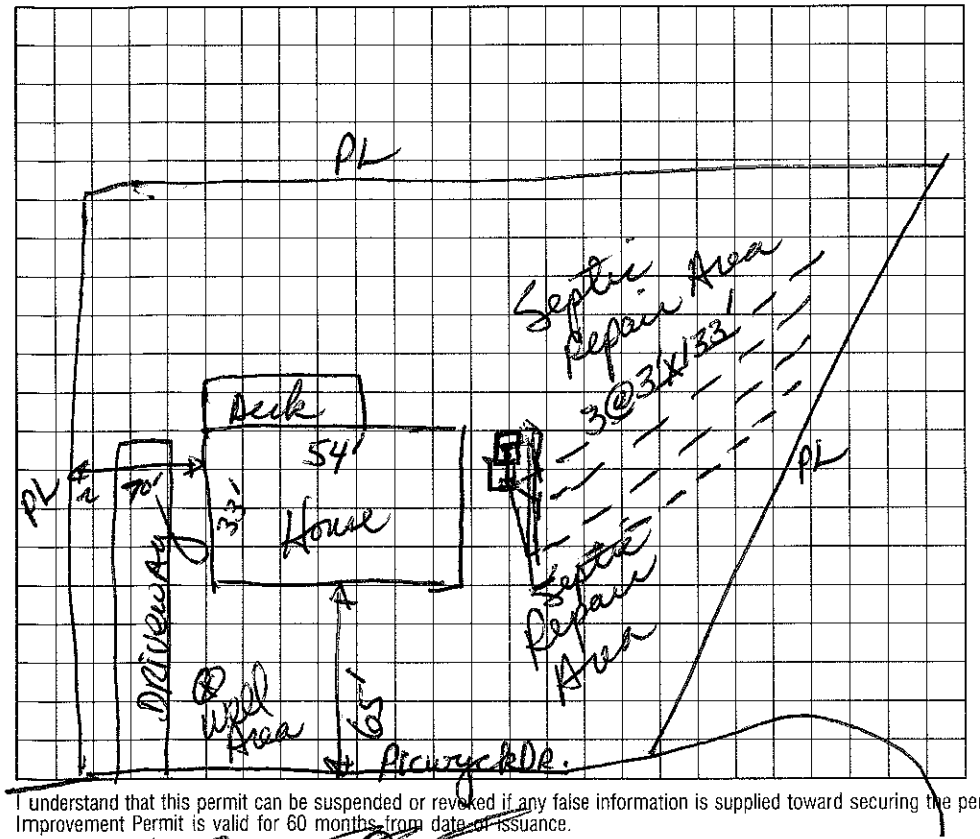

AS BUILT SKETCH

I understand that this permit can be suspended or revoked if any false information is supplied toward securing the permit/any unauthorized changes are made to the site/any unauthorized changes are made in the installation of the system. Improvement Permit is valid for 60 months from date of issuance.

Signed:

Improvement Permit by: date 8/12/93

Existing System Inspection by: date

Installed by: Larry Beam

Certificate of Completion by: Wesley Sparks RS. date 12/20/93

Operation Permit by: date

HEALTH DEPT. COPY: WHITE INSPECTION COPY (FINAL): GREEN OWNER COPY (FINAL): YELLOW INSPECTION COPY (INITIAL): PINK OWNER COPY (INITIAL): GOLD