IREDELL COUNTY HEALTH DEPARTMENT

STATESVILLE 704-878-5305 MOORESVILLE 704-664-5281

IMPROVEMENT PERMIT / CERTIFICATE OF COMPLETION / OPERATION PERMIT / EXISTING SYSTEM INSPECTION

PROPERTY DESCRIPTION NO. 1454 DATE 11/10/94 TAX MAP NO. IN 9B 12 Watershed: ☑ Yes ☐ No

OWNER OR CONTRACTOR LARRY MORROW PHONE: Business 664-3206 Home

ADDRESS PO BOX 1319 DAVIDSON, NC. 28036

LOCATION 152 EAST TR INTO PICWICK TR ON THISTLE LN. TO LOT ON (R) 4677-36-0741

SUBDIVISION PICWICK VILLAGE BLOCK / SECTION LOT 12 LOT AREA ~.931 AC SITE CLASS. P DESIGN FLOW 360 L.T.A.R. .3

Septic Tank: 1000 Gallons; STB 794 Date 4/6/94

Pump Tank: Gallons; PT Date

Pump Make: Model Serial No.

Nitrification Field: No Fields 1 Square Feet 1200 Linear Feet 400

No Lines 5 Trench Width 3' Max Trench Bottom Depth 28" Gravel Depth 12"

☑ New System ☐ Repair System Type: I (II) III, IV, V, VI

System Description: CONV.

Repair System Description: CONV.

Maintenance Agreement Required: ☐ Yes ☑ No

☑ House/Mod. Home No. Bedrooms 3

☐ Mobile Home No. Bathrooms 2

☐ Business No. Employees

☐ Other


☐ Slab ☑ Crawl Space ☐ Basement w/plumbing ☐ Basement wo/plumbing

Water Supply: ☑ Individual ☐ Community ☐ Public

Comments: KEEP TRENCHES ON SLOPE CONTOUR AS SHOWN IN DIRECTION SHOWN. TRENCH DEPTH 23" NO MORE THAN 28" TO TRENCH BOTTOM.

Comments: Installed as shown

INITIAL SITE SKETCH

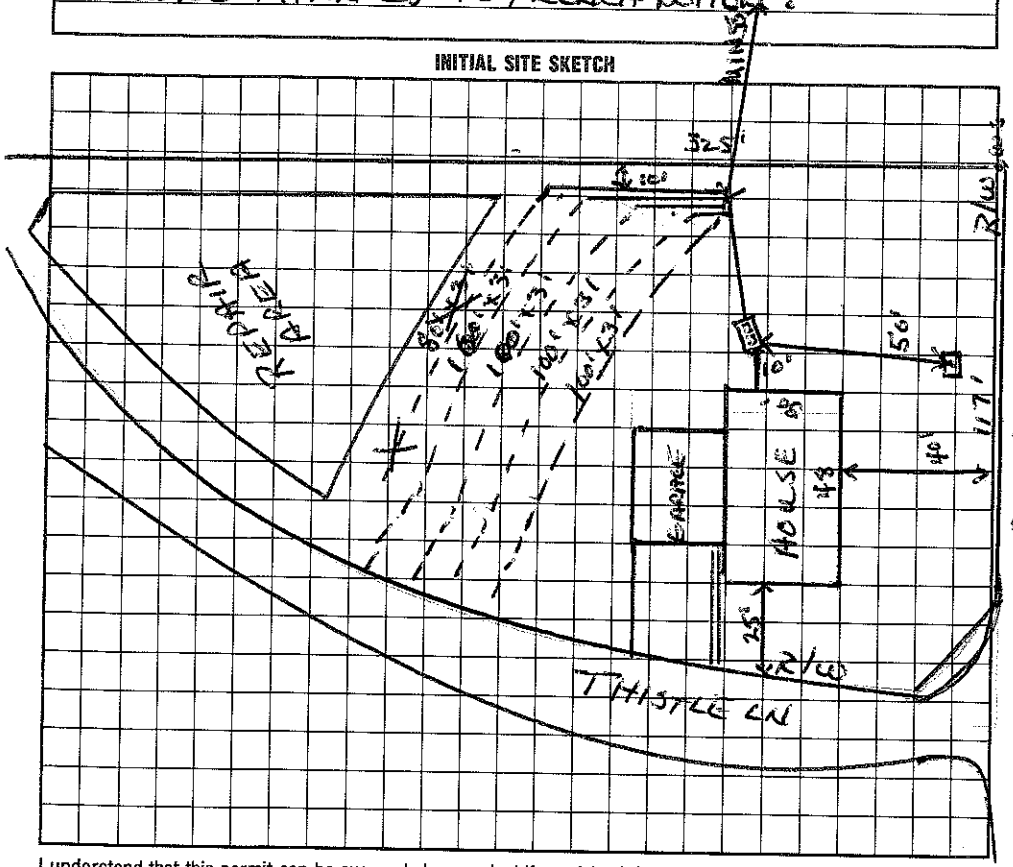

AS BUILT SKETCH

I understand that this permit can be suspended or revoked if any false information is supplied toward securing the permit/any unauthorized changes are made to the site/any unauthorized changes are made in the installation of the system. Improvement Permit is valid for 60 months from date of issuance.

Signed:

Improvement Permit by: Wesley Sparks R.S. date 11/10/94

Existing System Inspection by: date

Installed by: Larry Beam

Certificate of Completion by: Wesley Sparks R.S. date 5/31/94

Operation Permit by: date

HEALTH DEPT. COPY: WHITE INSPECTION COPY (FINAL): GREEN OWNER COPY (FINAL): YELLOW INSPECTION COPY (INITIAL): PINK OWNER COPY (INITIAL): GOLD