IREDELL COUNTY HEALTH DEPARTMENT

STATESVILLE 704-878-5305 MOORESVILLE 704-664-5281

IMPROVEMENT PERMIT / CERTIFICATE OF COMPLETION / OPERATION PERMIT / EXISTING SYSTEM INSPECTION

PROPERTY DESCRIPTION NO. 3158 DATE 2/28/95 TAX MAP NO. IN 9B 10 Watershed: ☒ Yes ☐ No

OWNER OR CONTRACTOR Larry Monroe PHONE: Business 664-3206 Home

ADDRESS PO Box 1317 Davidson NC. 28036 4677-36-3349

LOCATION 152 E, TR on Pickwick DR, TL on Dewey Thistle, straight off Cul de sac

SUBDIVISION Pickwick Village BLOCK / SECTION LOT 10 LOT AREA .986 SITE CLASS. PP DESIGN FLOW 360 L.T.A.R. .25 - .3

Septic Tank: 1600 Gallons; ST 394 Date 3/20/95
Pump Tank: Gallons; PT Date
Pump Make: Model Serial No.
Nitrification Field: No Fields 1 Square Feet 1200 Linear Feet 1400
No Lines X 3 Trench Width 36" Max Trench Bottom Depth 30" Gravel Depth 12"

☒ New System ☐ Repair System Type: I, (II), III, IV, V, VI
System Description: CONV - DIST BOX
Repair System Description:
Maintenance Agreement Required: ☐ Yes ☒ No


☒ House/Mod. Home No. Bedrooms 3
☐ Mobile Home No. Bathrooms 2
☐ Business No. Employees
☐ Other
☐ Slab ☐ Crawl Space ☐ Basement w/plumbing ☐ Basement wo/plumbing

Water Supply:
☒ Individual
☐ Community
☐ Public

Comments: (1) 5/12/95 - S/T location changed
(2) 3 lines 2 17 instead of 4

Comments:

INITIAL SITE SKETCH

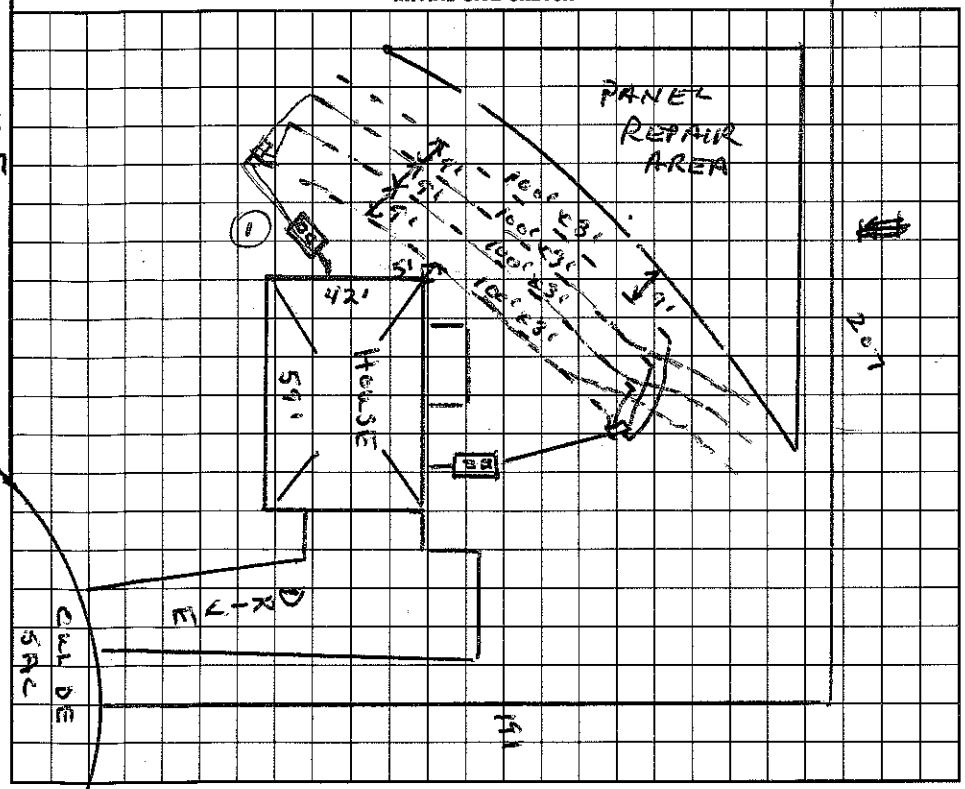

AS BUILT SKETCH

I understand that this permit can be suspended or revoked if any false information is supplied toward securing the permit/any unauthorized changes are made to the site/any unauthorized changes are made in the installation of the system. Improvement Permit is valid for 60 months from date of issuance.

Signed: X

Improvement Permit by: Wesley Sparks R.S. date 2/28/95

Existing System Inspection by: date

Installed by: Larry Beaver

Certificate of Completion by: Wesley Sparks R.S. date 5/17/95

Operation Permit by: date

HEALTH DEPT. COPY: WHITE INSPECTION COPY (FINAL): GREEN OWNER COPY (FINAL): YELLOW INSPECTION COPY (INITIAL): PINK OWNER COPY (INITIAL): GOLD