IREDELL COUNTY HEALTH DEPARTMENT

STATESVILLE 704-878-5305 MOORESVILLE 704-664-5281

IMPROVEMENT PERMIT / AUTHORIZATION TO CONSTRUCT / OPERATION PERMIT / EXISTING SYSTEM INSPECTION

PERMIT# ~~1870~~ 132904 PIN# 4677-36-~~7670~~ 1808 DATE Oct 25, 01

OWNER OR CONTRACTOR Douglas & Kelly Corrigan / Kemp Custom Homes PHONE: Business (704) 664-1450 Home

ADDRESS 1261 Oak Ridge Farm Hwy / Mooresville

LOCATION 150 East TR Alexander Acres Rd ≤ 1/8 mile on Right

SUBDIVISION Alexander Acres BLOCK / SECTION LOT 9 LOT AREA 2.79 Ac SITE CLASS. PS DESIGN FLOW 360 gpd L.T.A.R. .25-.3

Septic Tank: 1000 ✓ Gallons; STB 786 Date 7/17/06

Pump Tank: Gallons; PT Date

Pump Make: Model Serial No.

Nitrification Field: No Fields 1 Square Feet 1440 Linear Feet 480

No Lines 6 Trench Width 36" Max Trench Bottom Depth 36" Gravel Depth 12"

☑ New System ☐ Repair System Type: I, (II), III, IV, V, VI

System Description: Gravity conventional

Repair System Description: Same

Maintenance Agreement Required: ☐ Yes ☑ No

☐ Slab ☑ Crawl Space ☐ Basement w/plumbing ☐ Basement wo/plumbing

☑ House/Mod. Home ☐ Mobile Home ☐ Business ☐ Other


No. Bedrooms 3 No. Bathrooms 2 No. Employees

Water Supply: ☑ Individual ☐ Public ☐ Community

Comments:/Conditions:

Comments:/Conditions: ~~[illegible] installed [illegible]~~ – 25% Accepted System / Total 360' drainfield 6 lines installed

INITIAL SITE SKETCH

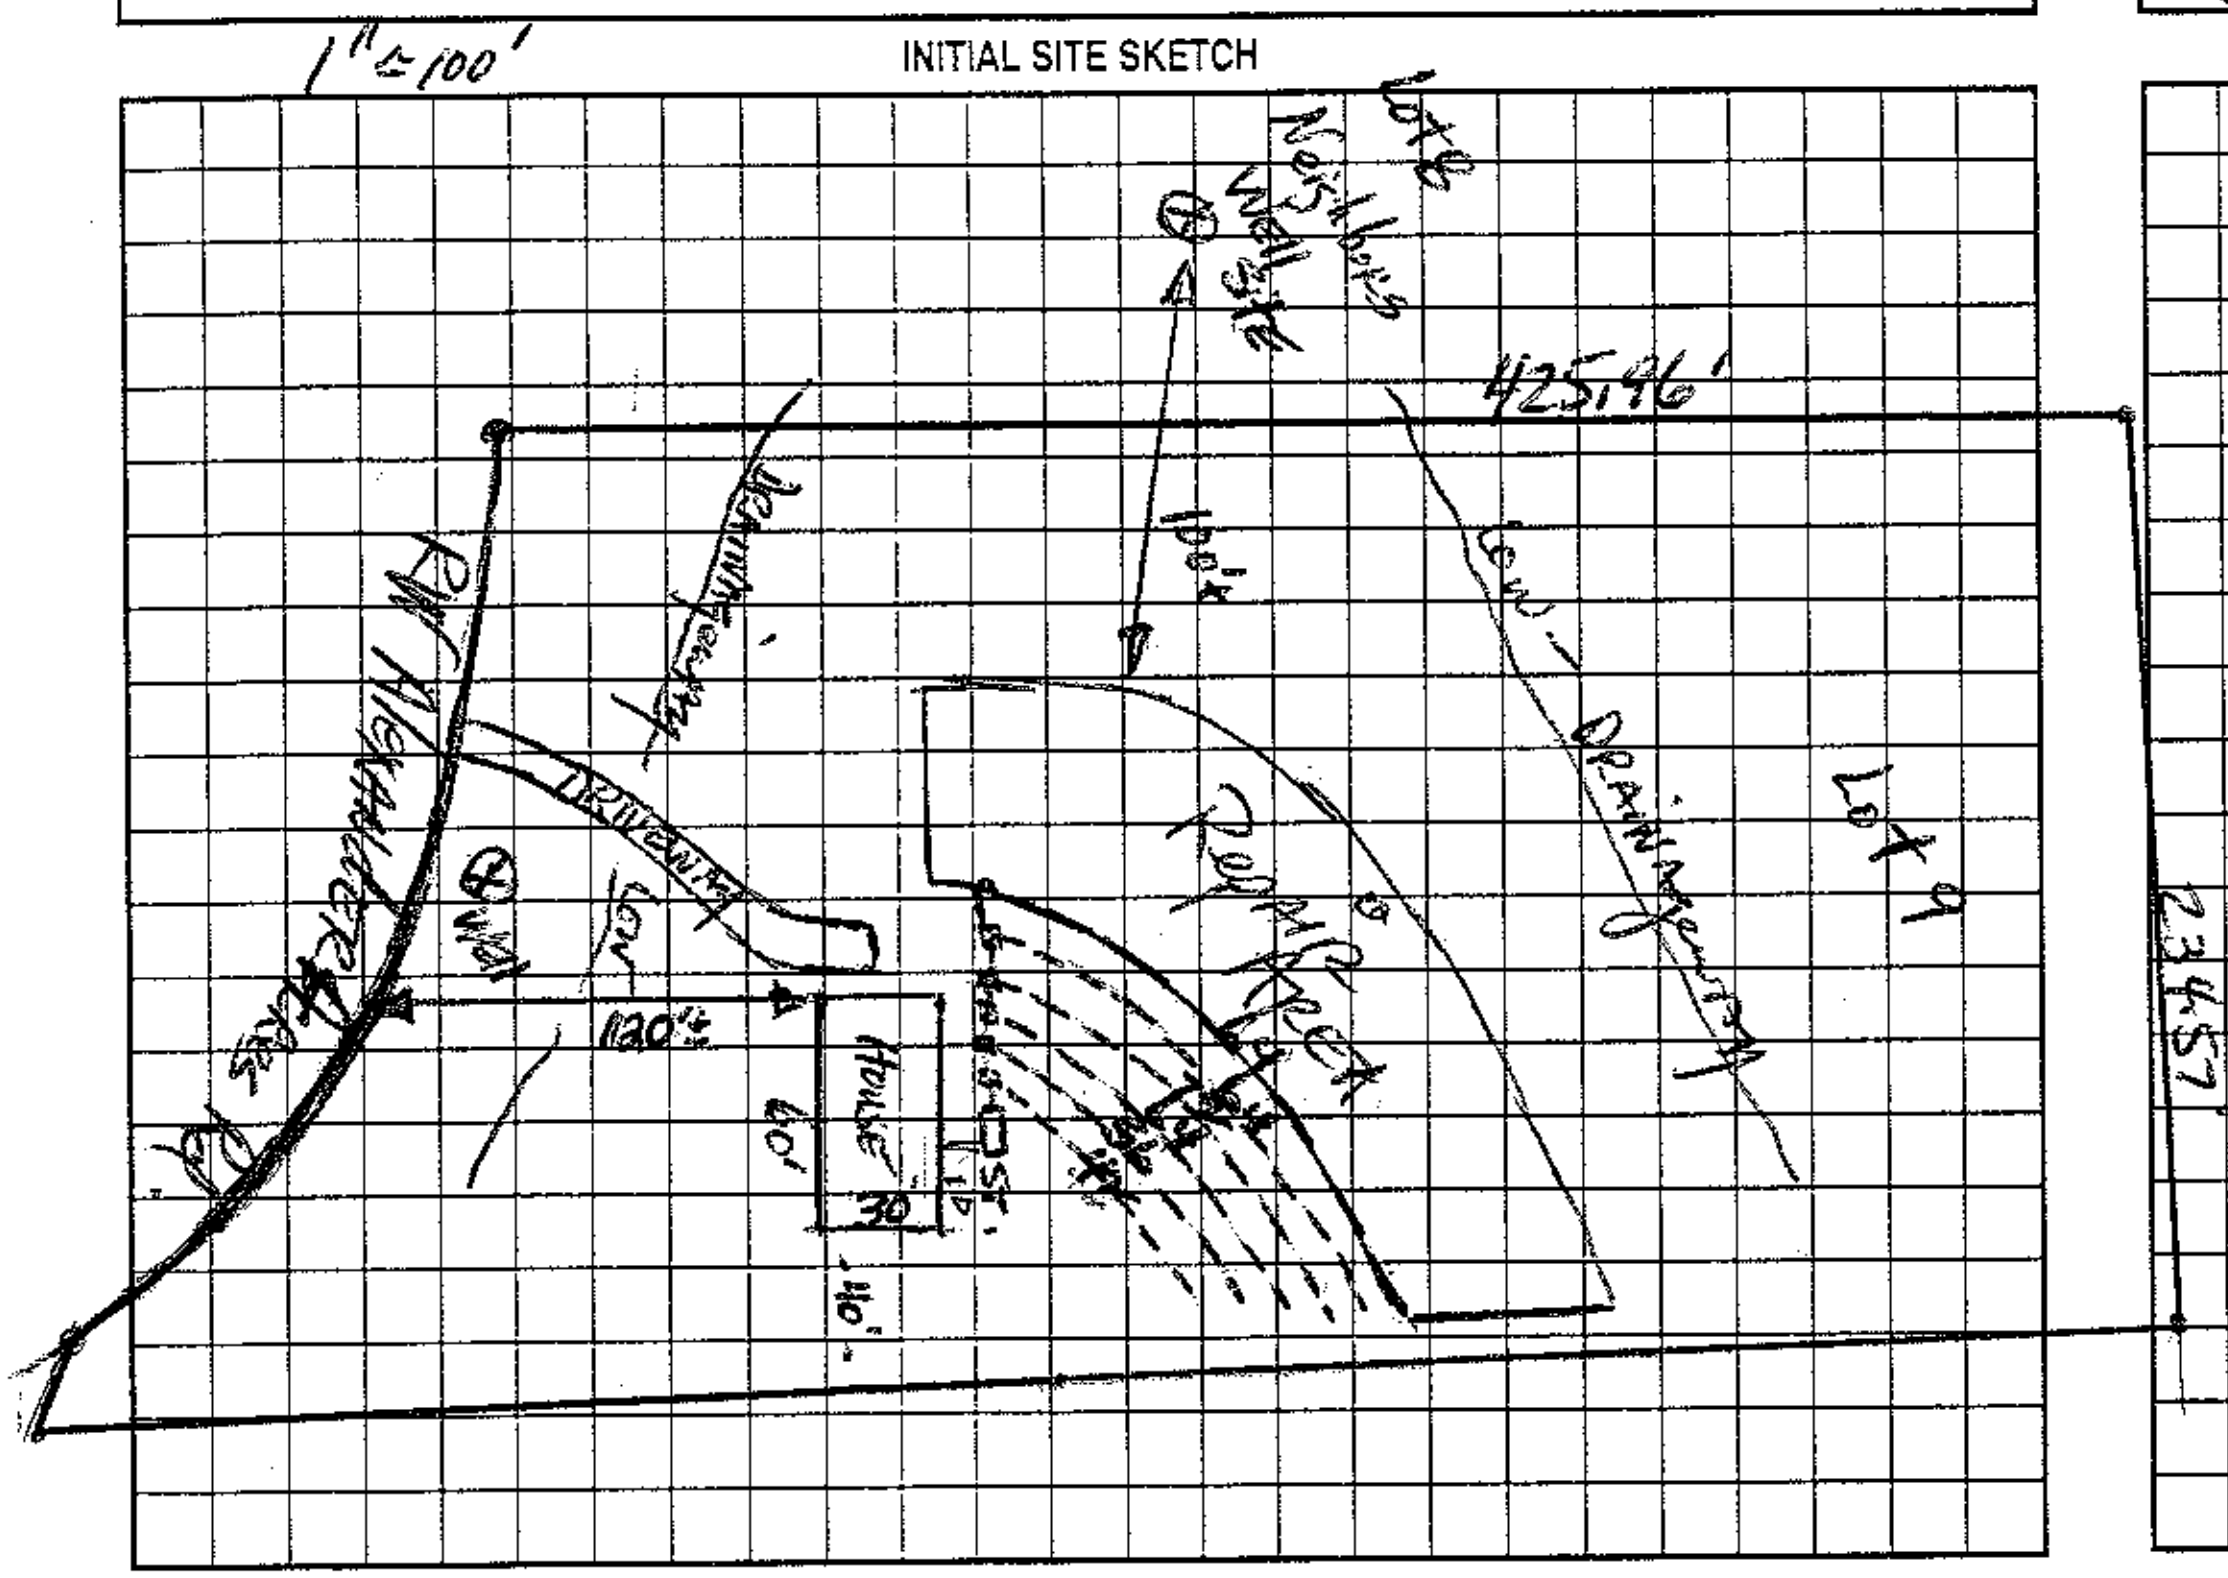

AS BUILT SKETCH

Permit can be suspended or revoked if any false information is supplied toward securing the permit/any unauthorized changes are made to the site/any unauthorized changes are made in the installation of the system. Improvement Permit with plat valid without expiration. Improvement Permit with site plan valid for sixty months. Authorization to Construct is valid for a period equal to that of Improvement Permit -- not to exceed sixty months.

Signed: [signature] date 11-19-01

Improvement Permit by: [signature], RS date 10-25-01

Authorization to Construct by: [signature] RS date 12/2/05

Installed by: G & M Enterprises

Operation Permit by: Wesley [signature] R.S. date 9/29/06

Existing System Inspection by: date

HEALTH DEPT. COPY: WHITE OWNER COPY (FINAL): YELLOW OWNER COPY (INITIAL): PINK