IREDELL COUNTY HEALTH DEPARTMENT

STATESVILLE 704-878-5305 MOORESVILLE 704-664-5281

IMPROVEMENT PERMIT / CERTIFICATE OF COMPLETION / OPERATION PERMIT / EXISTING SYSTEM INSPECTION

PROPERTY DESCRIPTION NO. _____ DATE Nov. 14, 95 TAX MAP NO. _____

OWNER OR CONTRACTOR John & Annette Russo PHONE: Business _____ Home _____ Watershed: ☐ Yes ☐ No

ADDRESS _____

LOCATION 150 Bypass (East) past Carriage Farms TR Alexander Acres Rd. TR Hygate Lane (#111) 1st lot on Rt.

SUBDIVISION _____ BLOCK / SECTION _____ LOT 1 LOT AREA _____ SITE CLASS. _____ DESIGN FLOW _____ L.T.A.R. _____

Septic Tank: Existing Gallons; STB _____ Date _____

Pump Tank: _____ Gallons; PT _____ Date _____

Pump Make: _____ Model _____ Serial No. _____

Nitrification Field: No Fields 2 Square Feet 600+ Linear Feet 200+

No Lines 2@100+ Trench Width 36" Max Trench Bottom Depth 36" Gravel Depth 12"

☐ New System ☑ Repair System Type: I, II, III, IV, V, VI

System Description: BR Valve to Conv. Laterals

Repair System Description: _____

Maintenance Agreement Required: ☐ Yes ☒ No

☐ House/Mod. Home ☒ Mobile Home ☐ Business ☐ Other

No. Bedrooms 3 No. Bathrooms 2 No. Employees _____


☐ Slab ☑ Crawl Space ☐ Basement w/plumbing ☐ Basement wo/plumbing

Water Supply: ☑ Individual ☐ Community ☐ Public


Comments: Mobile home set up partly across septic system sometime after the initial completion. Use ByPass Valve and Sch 40 and set new D-box where shown.

Comments:

INITIAL SITE SKETCH

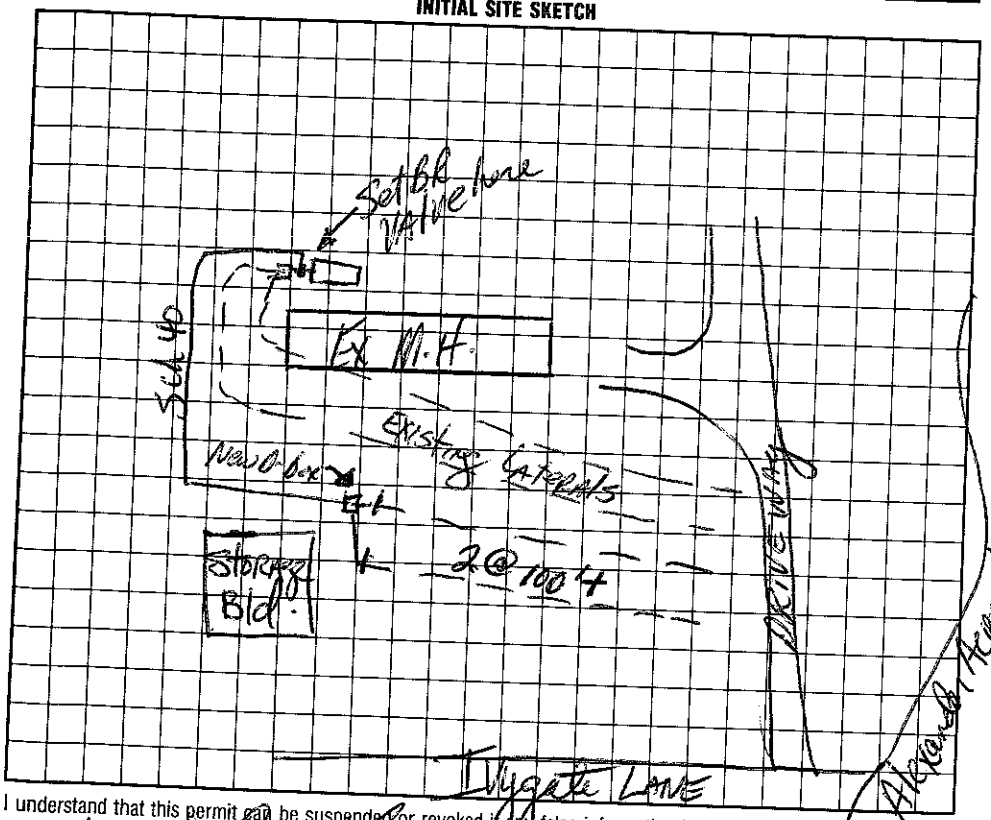

AS BUILT SKETCH

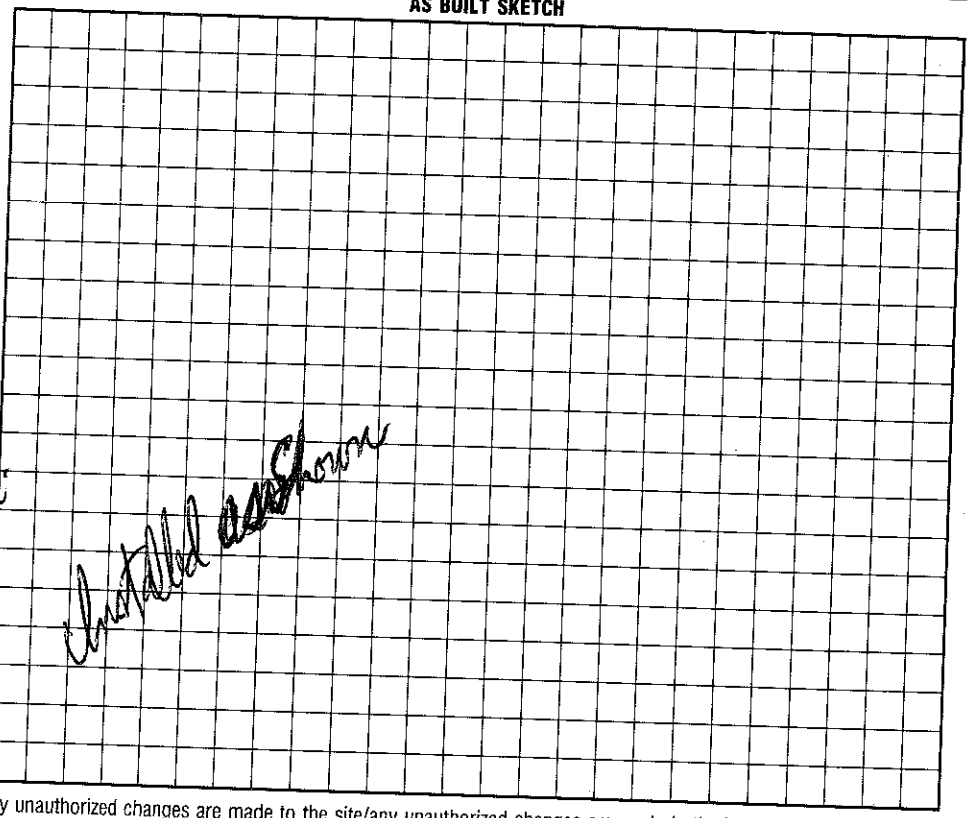

I understand that this permit can be suspended or revoked if any false information is supplied toward securing the permit/any unauthorized changes are made to the site/any unauthorized changes are made in the installation of the system.

Signed: John Russo

Improvement Permit by: [signature] date 11-14-95

Existing System Inspection by: [signature] date 11-14-95

to Contractor

Installed by: J K Bowles

Certificate of Completion by: _____ date _____

Operation Permit by: [signature] date 12-5-95

HEALTH DEPT. COPY: WHITE INSPECTION COPY (FINAL): GREEN OWNER COPY (FINAL): YELLOW INSPECTION COPY (INITIAL): PINK OWNER COPY (INITIAL): GOLD