IREDELL COUNTY HEALTH DEPARTMENT

Statesville Phone TR 3-7271 Mooresville Phone No. 664-5281

PERMIT TO INSTALL SEPTIC TANK

Permit No. 155 Permit Date 6-28-1923

Owner Marshall McCraw Address Mooresville

Installed By E. J. Ervin Address Mooresville


Location of Property 150 ~~East~~ To T L Wiggins Rt Then Right Woodland Heights Forest Drive Lot 19.

Tank		Capacity		Length of Lines		Fixtures	
Block	( )	1000	( )	225'	( )	No. of Baths	(2)
Precast	(✓)	1250	(✓)	250'	( )	Dishwasher	yes
		1500	( )	Other 260'		Garbage Grdr.	(yes
		Other				Other Washing Machine	

NOTIFY HEALTH DEPARTMENT AT LEAST EIGHT HOURS BEFORE TANK IS TO BE INSPECTED.

Final Inspection 6-28-1923 Approved (✓) Disapproved ( )

Remarks

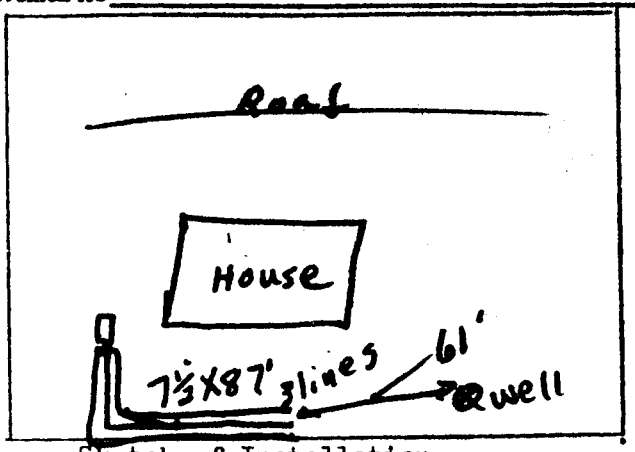

Sketch of Installation

J. C. Moore

Sanitarian