IREDELL COUNTY HEALTH DEPARTMENT

STATESVILLE 704-878-5305 130.00 Paid MOORESVILLE 704-664-5281

IMPROVEMENT PERMIT / AUTHORIZATION TO CONSTRUCT / OPERATION PERMIT / EXISTING SYSTEM INSPECTION

PERMIT# 108533 PIN# 4644389053 Darron Deal DATE 9-16-2002

OWNER OR CONTRACTOR ~~Tonya Tawnya Austin~~ Darron Deal PHONE: Business (704) 516-0659 Home 336 835-7500

ADDRESS P.O. Box 187 Jonesville, NC 28642

LOCATION Langtree Rd ~~FR~~ TL Meecklynn Rd TR West Paces TR Sea Hide Ct. #109

SUBDIVISION Westview BLOCK / SECTION ____ LOT 19 LOT AREA .88 Acre SITE CLASS PS DESIGN FLOW 480gpd L.T.A.R. .3

Septic Tank: 1000 Gallons; STB 1617 Date 8/24/04

Pump Tank: 1000 Gallons; PT 1617 Date 11/6/04

Pump Make: Goulds Model WE4a-3/4HP Serial No. 1/20/05

Nitrification Field: No Fields 1 Square Feet 1200' Linear Feet 400'

No Lines 5@80' Trench Width 36" Max Trench Bottom Depth 36" Gravel Depth N/A

☒ New System ☐ Repair System Type: I, II, III, IV, V, VI

System Description: Pump-PM-25% Reduction

Repair System Description: Pump-Innovative

Maintenance Agreement Required: ☐ Yes ☒ No

☒ House/Mod. Home ☐ Mobile Home ☐ Business ☐ Other

No. Bedrooms 4 No. Bathrooms 3.5 No. Employees ____

☐ Slab ☐ Crawl Space ☒ Basement w/plumbing ☐ Basement wo/plumbing


Water Supply: ☒ Individual ☐ Public ☐ Community

Comments:/Conditions: Keep Septic System at least 10' from PL & 50' from Lake. Keep tanks at least 50' from any well.


Comments:/Conditions: Note: Ok to do 4 lines @ 100' (Drain if installer can get it to fit & stay on Contour. Reviewed site plans & building plans & essential

INITIAL SITE SKETCH

Scale 1:50

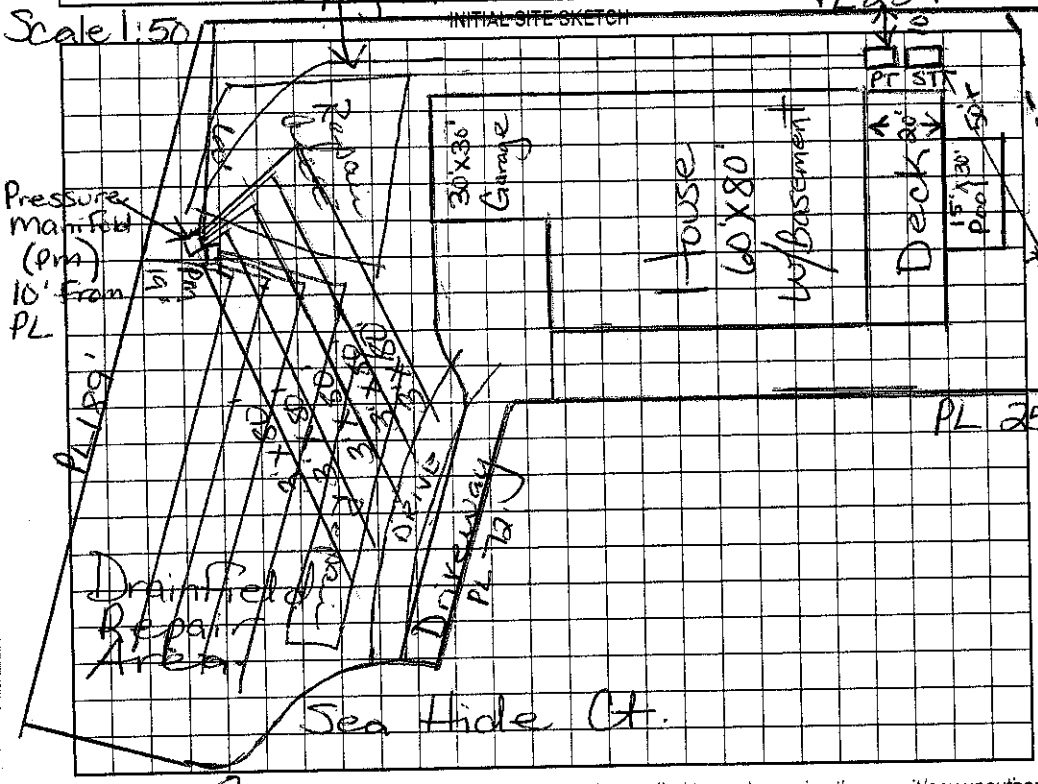

AS BUILT SKETCH in compliance with approved permit

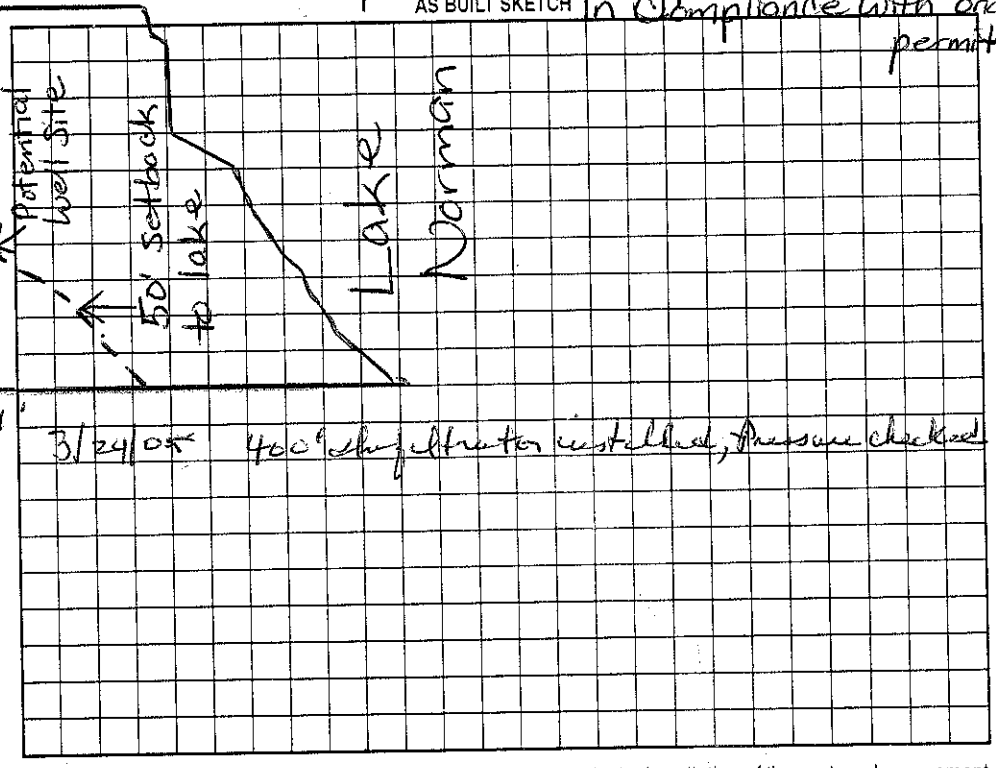

3/24/05 400' shallow trench installed, Pressure checked

Permit can be suspended or revoked if any false information is supplied toward securing the permit/any unauthorized changes are made to the site/any unauthorized changes are made in the installation of the system. Improvement Permit with plat valid without expiration. Improvement Permit with site plan valid for sixty months. Authorization to Construct is valid for a period equal to that of Improvement Permit – not to exceed sixty months.

Signed: ____ date 9/17/02. Installed by: A-1 Backhoe

Improvement Permit by: Maria H.H. Dolgan R.S. date 9/16/02 Operation Permit by: ____ date ____

Authorization to Construct by: Maria H.H. Dolgan R.S. date 12/10/03 Existing System Inspection by: ____ date ____

HEALTH DEPT. COPY: WHITE OWNER COPY (FINAL): YELLOW OWNER COPY (INITIAL): PINK