4677431636

COUNTY HEALTH DEPARTMENT

STATESVILLE 704-878-5305 MOORESVILLE 704-664-5281

IMPROVEMENT PERMIT / CERTIFICATE OF COMPLETION / OPERATION PERMIT / EXISTING SYSTEM INSPECTION

PROPERTY DESCRIPTION NO 4764 DATE 7/18/97 TAX MAP NO ~~4702~~ 4702-4-3 Watershed: ☐ Yes ☐ No

OWNER OR CONTRACTOR Anna Ray Tilley PHONE: Business 664-8539 Home 663-1006

ADDRESS 152 Linwood Rd Mooresville, NC

LOCATION U. Main TR 150 TR Alexander Acres to end of road on ~~right~~ LEFT

SUBDIVISION ~~ALEXANDER ACRES~~ Tilley Estates BLOCK / SECTION ____ LOT 3 LOT AREA 3.81 Acres SITE CLASS. 05 DESIGN FLOW 480gpd L.T.A.R. .3

Septic Tank: 1000 Gallons; STB ____ Date 7/13/98

Pump Tank: ____ Gallons; PT ____ Date ____

Pump Make: ____ Model ____ Serial No. ____

Nitrification Field: No Fields 1 Square Feet 1605 Linear Feet 535

No Lines ~~5~~ 3 Trench Width 36" Max Trench Bottom Depth 26" Gravel Depth 12"

☒ New System ☐ Repair System Type: I, II, III, IV, V, VI

System Description: Gravity - Conventional

Repair System Description: Pump - Conventional

Maintenance Agreement Required: ☐ Yes ☒ No

☒ House/Mod. Home No. Bedrooms 4

☐ Mobile Home No. Bathrooms 3

☐ Business No. Employees ____

☐ Other ____


☐ Slab ☐ Crawl Space ☒ Basement w/plumbing ☐ Basement wo/plumbing

Water Supply: ☒ Individual ☐ Community ☐ Public

Comments: Keep System 15' From basement

Comments:

INITIAL SITE SKETCH Scale 1:100

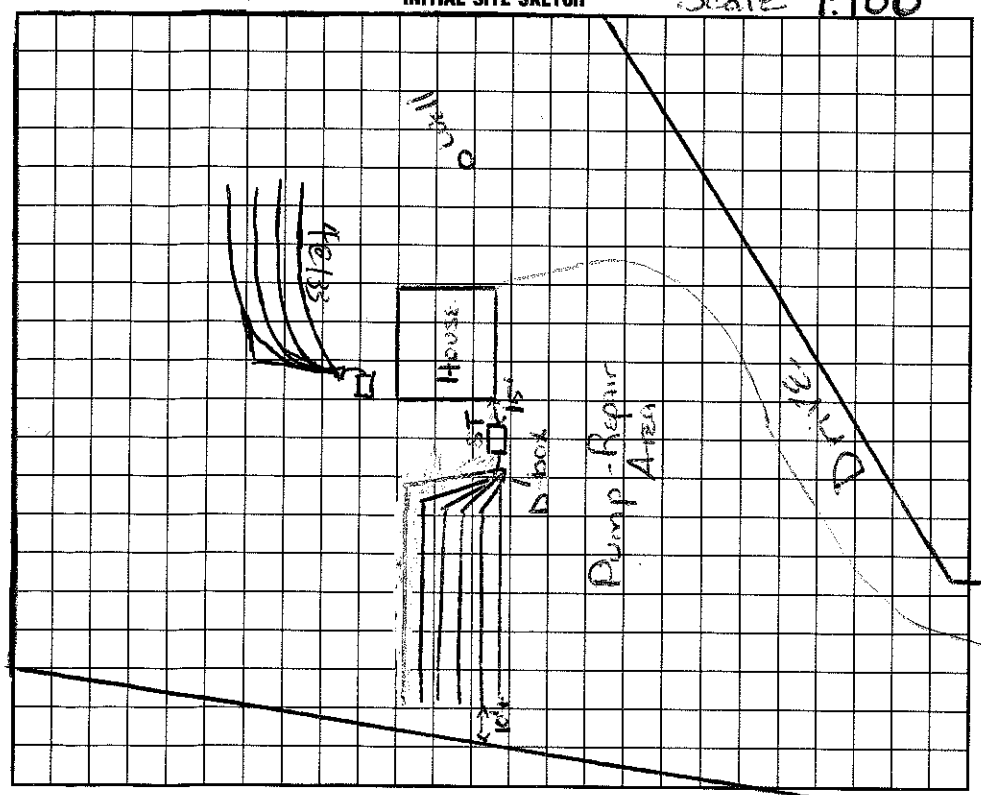

AS BUILT SKETCH

I understand that this permit can be suspended or revoked if any false information is supplied toward securing the permit/any unauthorized changes are made to the site/any unauthorized changes are made in the installation of the system. Improvement Permit is valid for 60 months from date of issuance.

Signed: Anna Tilley

Improvement Permit by: Maina M. Dotson date 8/7/97

~~Existing System Inspection by:~~ Maina M. Dotson date 8/7/98

Installed by: ORBISON

Certificate of Completion by: ____ date ____

Operation Permit by: [signature] date 9/16/98

Const. Auth

HEALTH DEPT. COPY: WHITE INSPECTION COPY (FINAL): GREEN OWNER COPY (FINAL): YELLOW INSPECTION COPY (INITIAL): PINK OWNER COPY (INITIAL): GOLD