IREDELL COUNTY HEALTH DEPARTMENT

STATESVILLE 704-878-5305 MOORESVILLE 704-664-5281

IMPROVEMENT PERMIT / AUTHORIZATION TO CONSTRUCT / OPERATION PERMIT / EXISTING SYSTEM INSPECTION

PERMIT # 157416 PIN # 4677-46-0759 DATE 7-23-09

OWNER or APPLICANT YAE VANG PHONE: Business 704-746-4778 Home:

OWNER or APPLICANT ADDRESS 129 JCCR MVILLE

LOCATION / DIRECTIONS 150, TR ALEXANDER

SUBDIVISION CARRIGAN/ALEXANDER ACRES BLOCK / SECTION LOT # 1 LOT AREA ~1AC DESIGN FLOW 480 L.T.A.R. .25

Septic Tank 1000 Gallons: STB 1017 Date 6-16-09
Pump Tank 1000 Gallons: PT 17 Date 3-17-09
Pump Make GOULDS Model PES1 Serial # 1/2 HP
Nitrification Field No Fields 1 No Lines 6 Linear Feet 480'
Trench Width 36" Max. Trench Bottom Depth 36" Gravel Depth —

☒ New System ☐ Repair ☐ Expansion System Type I II III IV V VI
System Description: PM- 25%
Repair System Description: LP- 50%
Maintenance Agreement Required ☐ YES ☒ NO INITIALLY
☐ GRAVITY ☒ PRESSURE


☒ Residence No. Bedrooms 4
☐ Business No. Persons
☐ Other No. Employees
☐ Slab ☒ Crawl Space
☐ Basement w/plumbing ☐ Basement w/o plumbing

Water Supply: ☒ Private ☐ Public ☐ Community


Comments / Conditions

Comments / Conditions 1) KEEP MIN 50' FROM ANY WELL

INITIAL SITE SKETCH

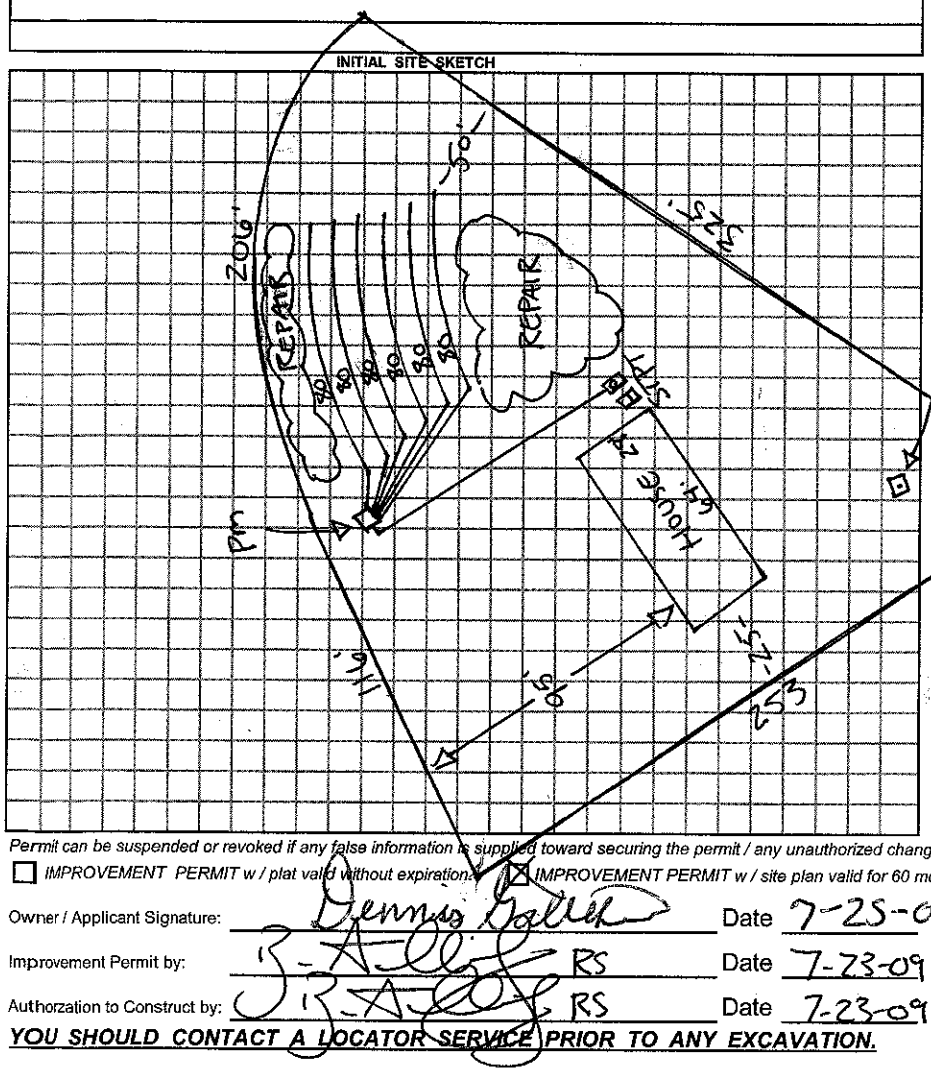

AS BUILT SKETCH

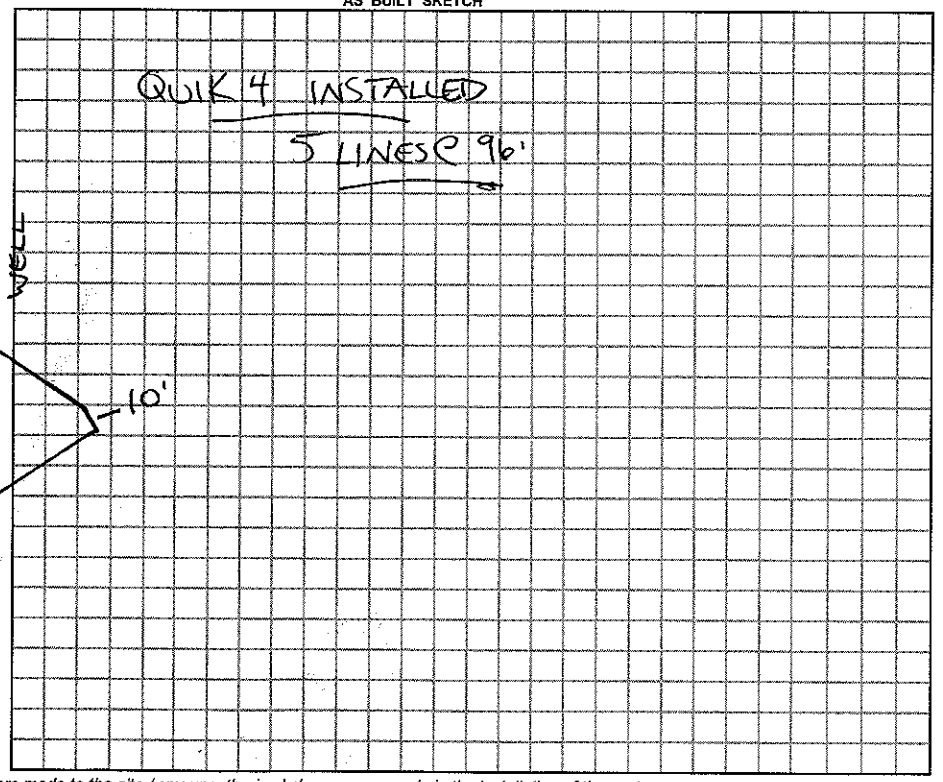

Permit can be suspended or revoked if any false information is supplied toward securing the permit / any unauthorized changes are made to the site / any unauthorized changes are made in the installation of the system.

☐ *IMPROVEMENT PERMIT w / plat valid without expiration.* ☒ *IMPROVEMENT PERMIT w / site plan valid for 60 mos.* ☒ *AUTHORIZATION TO CONSTRUCT valid for period equal to IMPROVEMENT PERMIT-not to exceed 60 mo.*

Owner / Applicant Signature: Yae Vang Date 7-25-09

Improvement Permit by: B-A-09 RS Date 7-23-09

Authorization to Construct by: B-A-09 RS Date 7-23-09

YOU SHOULD CONTACT A LOCATOR SERVICE PRIOR TO ANY EXCAVATION.

Installed by: GUNTER GRADING

Operation Permit by: B-A-09 RS Date: 9-8-09

Existing System Inspected by: Date:

WHITE COPY Environmental Health YELLOW COPY (Final) Owner / Applicant PINK COPY (Initial) Owner / Applicant