IREDELL COUNTY HEALTH DEPARTMENT

$330 400

STATESVILLE 704-878-5305 MOORESVILLE 704-664-5281

IMPROVEMENT PERMIT / AUTHORIZATION TO CONSTRUCT / OPERATION PERMIT / EXISTING SYSTEM INSPECTION

PERMIT# [illegible] 109163 PIN# [illegible] 4677-46-1449 4677461449 DATE 9/24/01

OWNER OR CONTRACTOR Douglas W Comeaux // Historic Designs PHONE: Business 704-664-5222 Home

ADDRESS 1261 Oak Ridge Rd. Mooresville NC. 28115

LOCATION Main St. (R) on 150 E (R) Alexander Acres Rd. on (L)

SUBDIVISION Douglas Comeaux BLOCK / SECTION LOT 3 LOT AREA ~1.2 Ac SITE CLASS. PS DESIGN FLOW 360 L.T.A.R. .3

Septic Tank: 1000 Gallons; STB 794 Date

Pump Tank: 1000 Gallons; PT 283 Date

Pump Make: Model Serial No.

Nitrification Field: No Fields 1 Square Feet 900 Linear Feet 300

No Lines 4 @ 75' Trench Width 3' Max Trench Bottom Depth 30" Gravel Depth No

☑ New System ☐ Repair System Type: I, II, III, IV, V, VI

System Description: PM → CH PLAS or EZ FLOW

Repair System Description: SAME

Maintenance Agreement Required: ☐ Yes ☒ No

☑ House/Mod. Home ☐ Mobile Home ☐ Business ☐ Other

No. Bedrooms 3 No. Bathrooms 3 No. Employees

Water Supply: ☒ Individual ☐ Public ☐ Community


☐ Slab ☒ Crawl Space ☐ Basement w/plumbing ☐ Basement wo/plumbing

Comments:/Conditions:


Comments:/Conditions: Checked drainlines 10/22/02

(1" = 50')

INITIAL SITE SKETCH

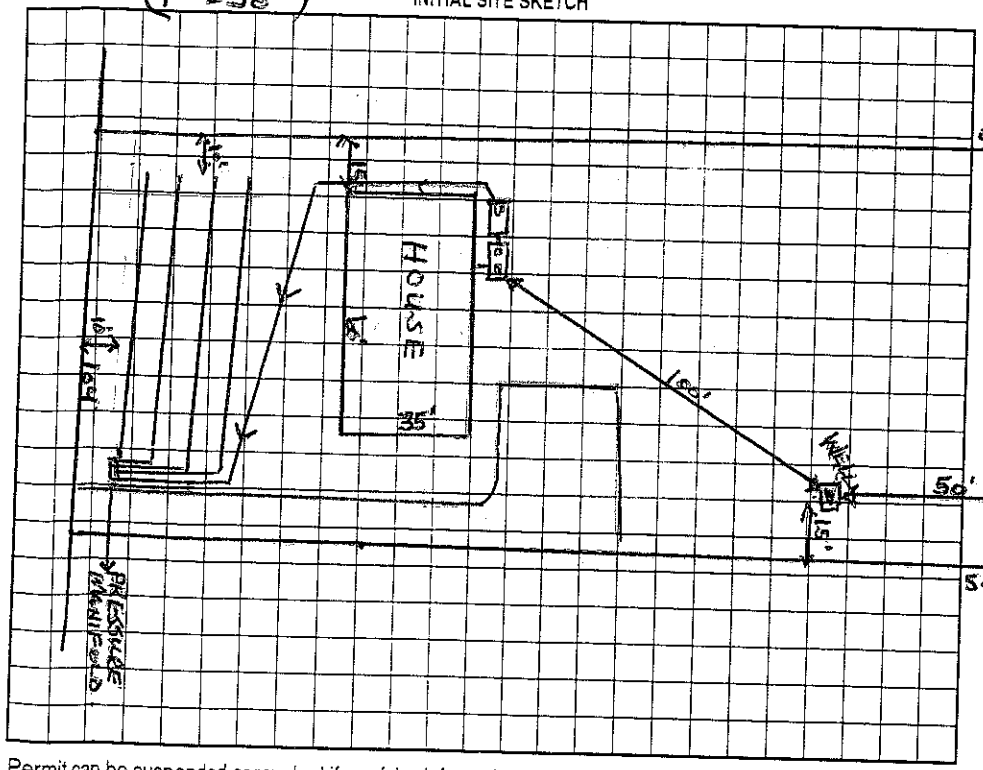

AS BUILT SKETCH

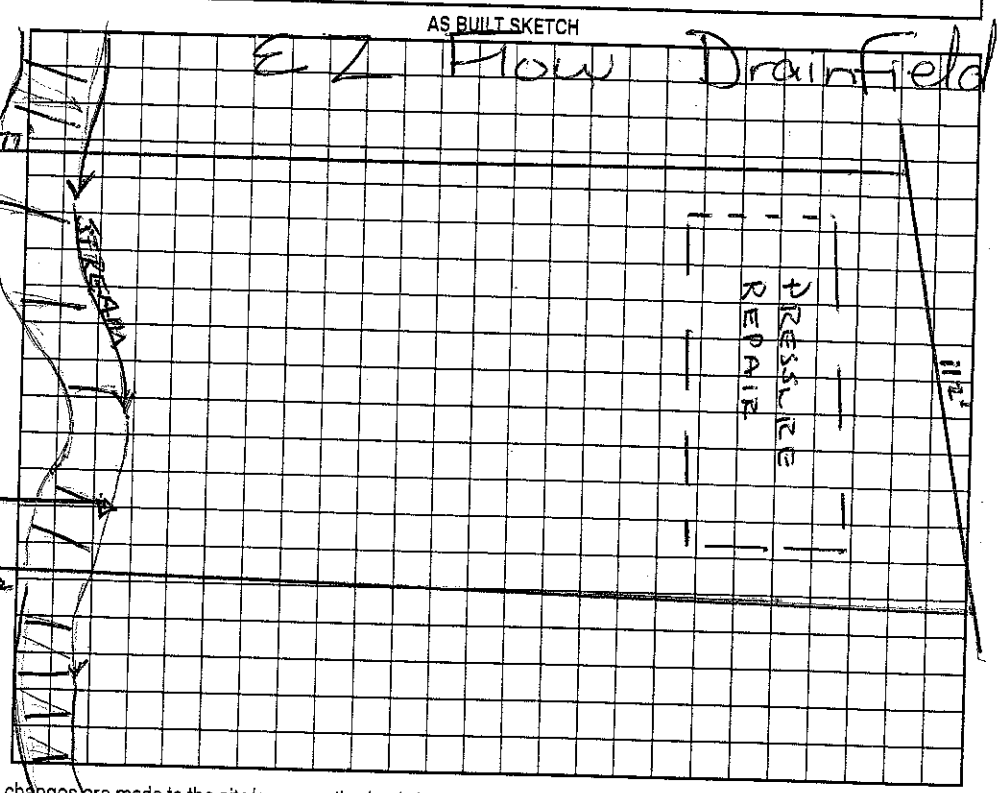

Permit can be suspended or revoked if any false information is supplied toward securing the permit/any unauthorized changes are made to the site/any unauthorized changes are made in the installation of the system. Improvement Permit with plat valid without expiration. Improvement Permit with site plan valid for sixty months. Authorization to Construct is valid for a period equal to that of Improvement Permit – not to exceed sixty months.

Signed: [signature] date

Improvement Permit by: [signature] RS. date 9/24/01

Authorization to Construct by: [signature] RS date 7-9-02

Installed by: Richard Abernathy

Operation Permit by: [signature] RS date 2/21/03

Existing System Inspection by: date

HEALTH DEPT. COPY: WHITE OWNER COPY (FINAL): YELLOW OWNER COPY (INITIAL): PINK