IREDELL COUNTY HEALTH DEPARTMENT

STATESVILLE 704-878-5305 MOORESVILLE 704-664-5281

IMPROVEMENT PERMIT / CERTIFICATE OF COMPLETION / OPERATION PERMIT / EXISTING SYSTEM INSPECTION

PROPERTY DESCRIPTION NO. 16002 DATE April 25, '95 TAX MAP NO. 1N8A11 Watershed: ☐ Yes ☐ No

OWNER OR CONTRACTOR Ronald Cruem PHONE: Business 4677-48-8827 Home 663-2784

ADDRESS 129 Burley Dr. Mooresville, NC.

LOCATION 150 E past Carrigan Farms Tr into Oakmeadow on left near end

SUBDIVISION Oakmeadow BLOCK / SECTION ____ LOT 11 LOT AREA 120'X353' SITE CLASS. 5 DESIGN FLOW 360gpd L.T.A.R. .3

Septic Tank: 1000 Gallons; STB 625 Date 11-2-95

Pump Tank: ____ Gallons; PT ____ Date ____

Pump Make: ____ Model ____ Serial No. ____

Nitrification Field: No Fields 1 Square Feet 1200 Linear Feet 400

No Lines 5 Trench Width 36" Max Trench Bottom Depth 24" Gravel Depth 12"

☑ New System ☐ Repair System Type: I, II, III, IV, V, VI

System Description: Shallow grav. conventional

Repair System Description: pumped shallow conv.

Maintenance Agreement Required: ☐ Yes ☑ No

☑ House/Mod. Home ☐ Mobile Home ☐ Business ☐ Other

No. Bedrooms 3 No. Bathrooms 2 No. Employees ____

☐ Slab ☑ Crawl Space ☐ Basement w/plumbing ☐ Basement wo/plumbing


Water Supply: ☑ Individual ☐ Community ☐ Public

Comments: Laterals must follow contour and be kept shallow — no deeper than 24" trench bottom depth.


Comments:

1"=50'

INITIAL SITE SKETCH

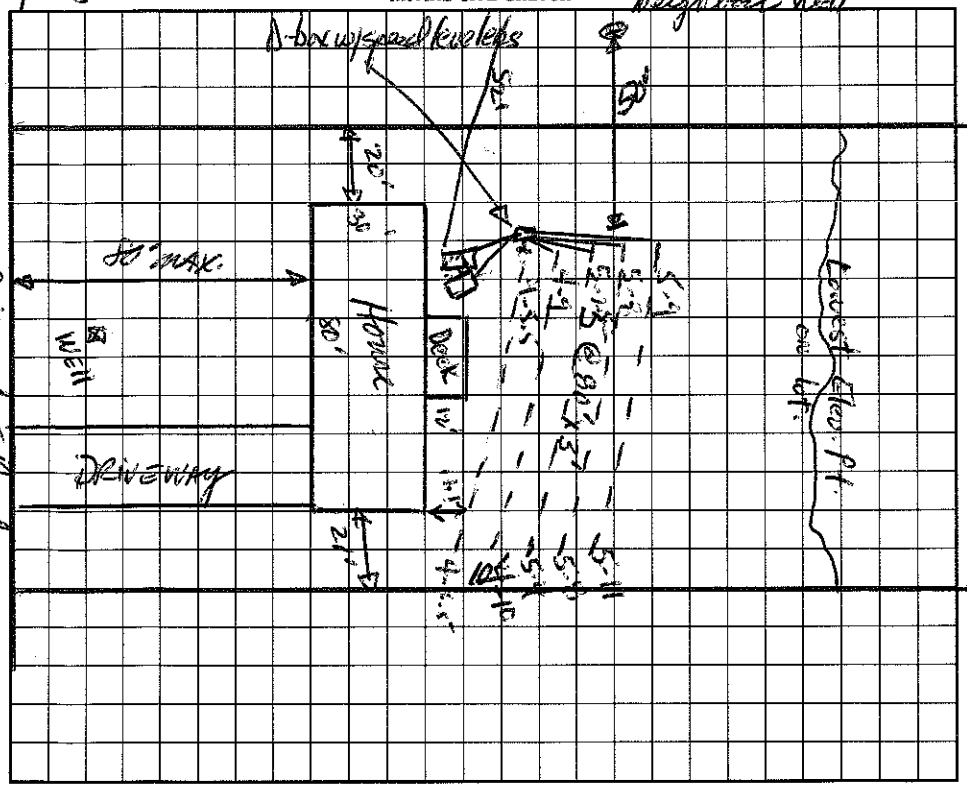

AS BUILT SKETCH

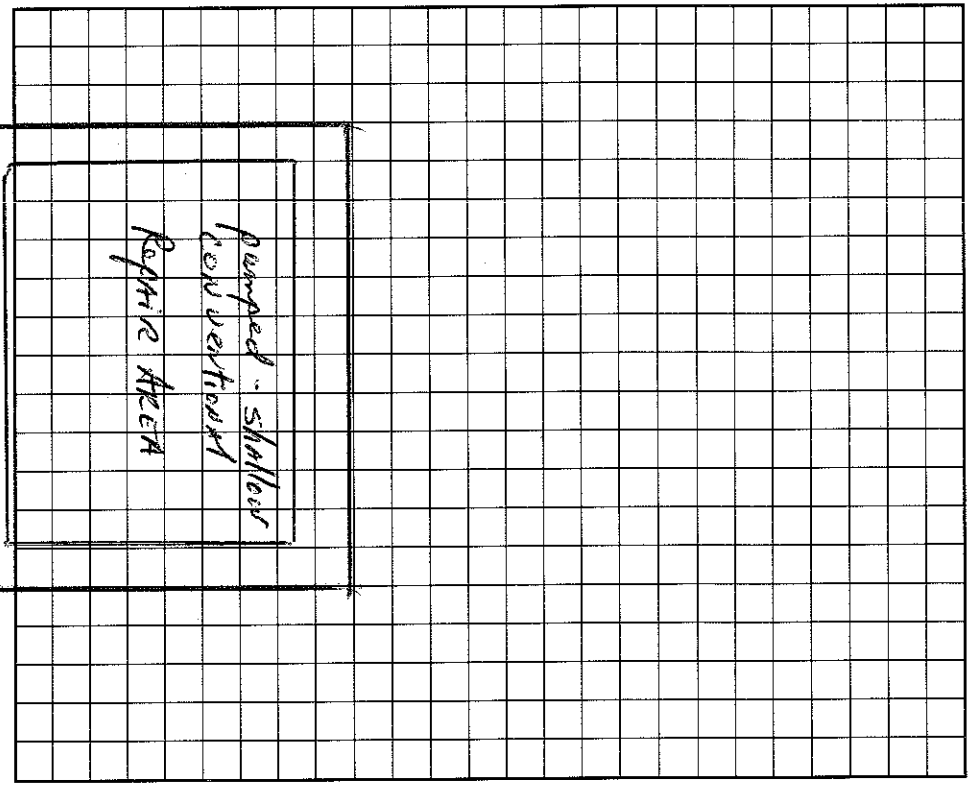

I understand that this permit can be suspended or revoked if any false information is supplied toward securing the permit/any unauthorized changes are made to the site/any unauthorized changes are made in the installation of the system. Improvement Permit is valid for 60 months from date of issuance.

Signed: [signature] Installed by: Rowan Septic Tank

Improvement Permit by: [signature] RS date 4/25/95 Certificate of Completion by: ____ date ____

Existing System Inspection by: ____ date ____ Operation Permit by: Wesley Sparks R.S. date 3/1/96

HEALTH DEPT. COPY: WHITE INSPECTION COPY (FINAL): GREEN OWNER COPY (FINAL): YELLOW INSPECTION COPY (INITIAL): PINK OWNER COPY (INITIAL): GOLD