IREDELL COUNTY HEALTH DEPARTMENT

STATESVILLE 704-878-5305 MOORESVILLE 704-664-5281

IMPROVEMENT PERMIT / CERTIFICATE OF COMPLETION / OPERATION PERMIT / EXISTING SYSTEM INSPECTION

PROPERTY DESCRIPTION NO. 20599 DATE May 26, '95 TAX MAP NO. 1N8A12 Watershed: ☐ Yes ☐ No

OWNER OR CONTRACTOR Greg & Libby Bender PHONE: Business 4697-49-8011 Home

ADDRESS #903, 900 W. Wilson Mooresville

LOCATION 150 E. of Oakmeadow on left near end

SUBDIVISION Oakmeadow BLOCK / SECTION LOT 12 LOT AREA 1.4Ac SITE CLASS B per 1957 DESIGN FLOW 360gpd L.T.A.R. .3 / .15-LPP

Septic Tank: 1000 Gallons; STB 325 Date 4/9/96

Pump Tank: Gallons; PT Date

Pump Make: Model Serial No.

Nitrification Field: No Fields 1 Square Feet 1200 Linear Feet 400

No Lines 8 (4+4) Trench Width 36" Max Trench Bottom Depth (18") Gravel Depth 12"

☑ New System ☐ Repair System Type: I, II, III, IV, V, VI

System Description: gravity conventional

Repair System Description: LPP at rear

Maintenance Agreement Required: ☐ Yes ☑ No initial sys

☑ House/Mod. Home No. Bedrooms 3

☐ Mobile Home No. Bathrooms 2

☐ Business No. Employees

☐ Other

☐ Slab ☐ Crawl Space ☐ Basement w/plumbing ☑ Basement wo/plumbing


Water Supply: ☑ Individual ☐ Community ☐ Public

Comments: Plumbing must exit at a level to accomodate specified MAX trench bottom depth or a pump will be required.


Comments:

INITIAL SITE SKETCH

1"=60'

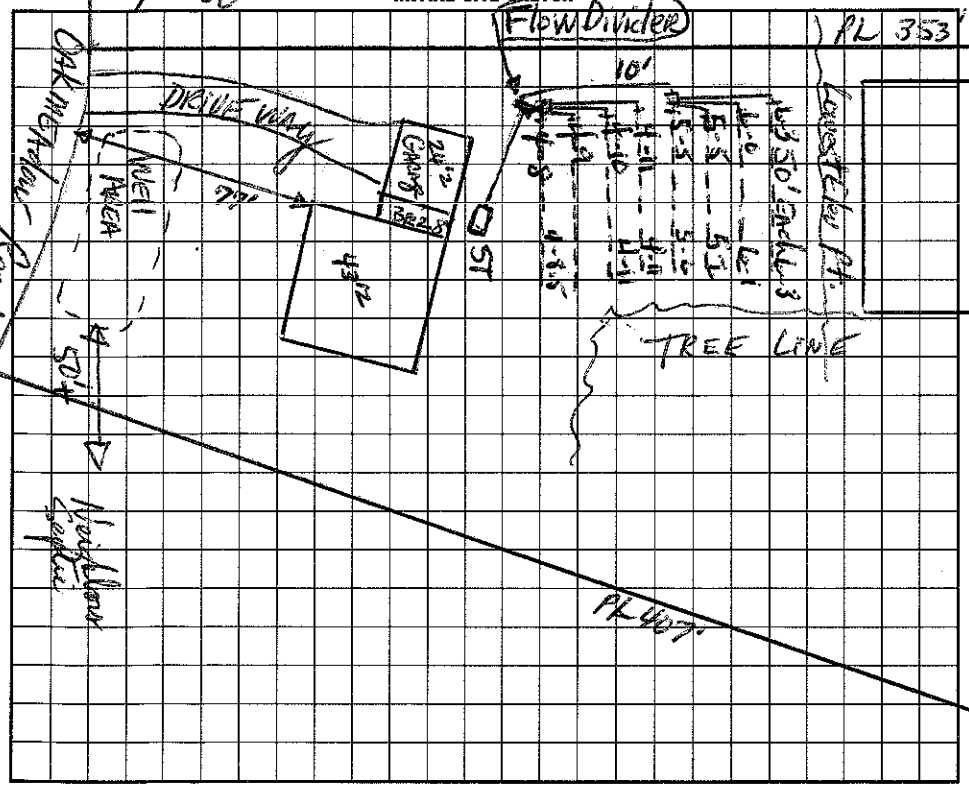

AS BUILT SKETCH

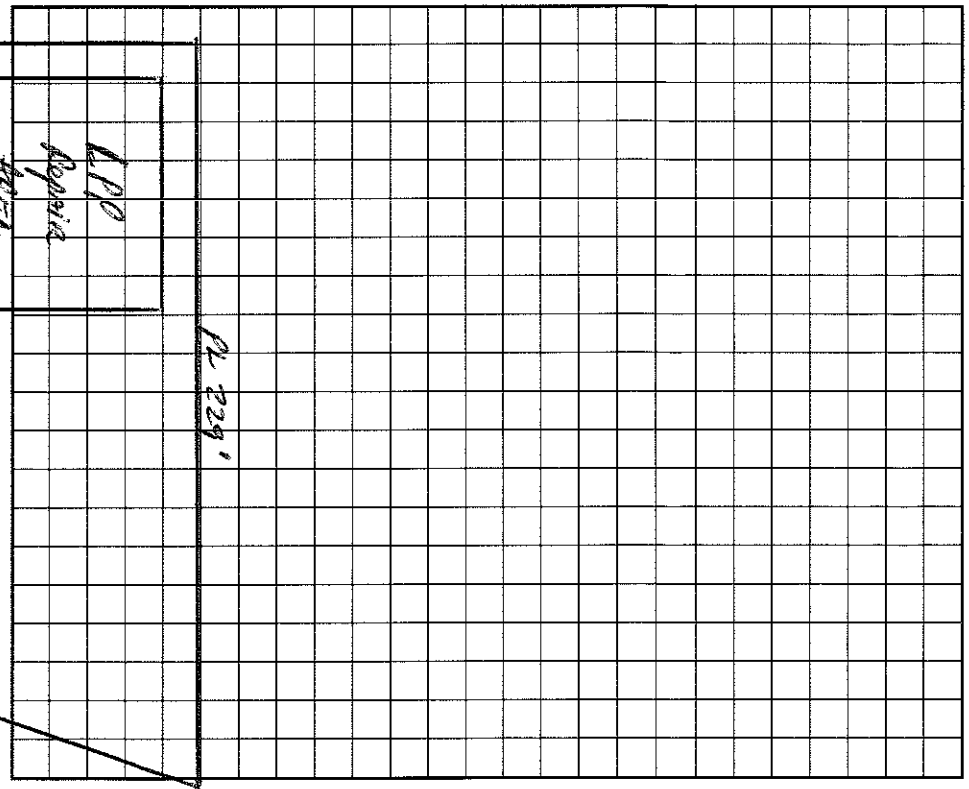

I understand that this permit can be suspended or revoked if any false information is supplied toward securing the permit/any unauthorized changes are made to the site/any unauthorized changes are made in the installation of the system. Improvement Permit is valid for 60 months from date of issuance.

Signed: K. T. Spaugh Sanders

Improvement Permit by: [illegible], RS date 5/26/95

Existing System Inspection by: date

Installed by: Rowan Septic Tank

Certificate of Completion by: date

Operation Permit by: Wesley Sparks RS. date 5/30/96

HEALTH DEPT. COPY: WHITE INSPECTION COPY (FINAL): GREEN OWNER COPY (FINAL): YELLOW INSPECTION COPY (INITIAL): PINK OWNER COPY (INITIAL): GOLD