$150

IREDELL COUNTY HEALTH DEPARTMENT

STATESVILLE 704-878-5305 MOORESVILLE 704-664-5281

IMPROVEMENT PERMIT / AUTHORIZATION TO CONSTRUCT / OPERATION PERMIT / EXISTING SYSTEM INSPECTION

PERMIT# 129029 PIN# 4677 50 2501 DATE 7/6/05

OWNER OR CONTRACTOR Robert P Bostian Jr. PHONE: Business Home 704-664-4562

ADDRESS 356 Brumley Rd. Mooresville, NC. 28115

LOCATION 150 E TR Brumley Rd. ~ 1 mile on (R) #356, first pond, behind house to shop

SUBDIVISION No BLOCK / SECTION LOT LOT AREA 18.13 SITE CLASS. PS DESIGN FLOW 100 L.T.A.R. .3

Septic Tank: 1000 Gallons; STB 31~ Date 9/27/05
Pump Tank: Gallons; PT Date
Pump Make: Model Serial No.
Nitrification Field: No Fields 1 Square Feet 300 Linear Feet 100
No Lines 2@50' Trench Width 3' Max Trench Bottom Depth 3

[X] New System [ ] Repair System Type: I (II) III, IV, V, VI
System Description: Accepted System - 25% Reduced
Repair System Description: Same
Maintenance Agreement Required: [ ] Yes [X] No

[ ] House/Mod. Home No. Bedrooms
[ ] Mobile Home No. Bathrooms
[ ] Business No. Employees
[X] Other Bath/Accessory Bldg.


Gravel Depth No [X] Slab [ ] Crawl Space [ ] Basement w/plumbing [ ] Basement wo/plumbing

Water Supply: [X] Individual [ ] Public [ ] Community Home

Comments:/Conditions:
Type II

Comments:/Conditions:
Low pressure pipe installed

INITIAL SITE SKETCH

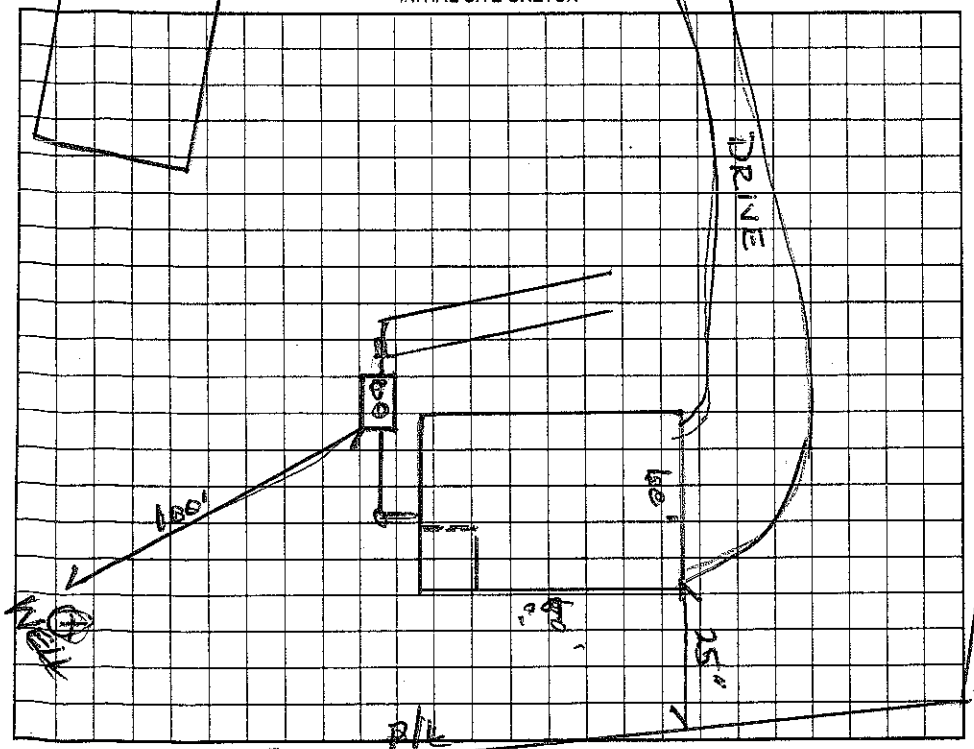

AS BUILT SKETCH

Permit can be suspended or revoked if any false information is supplied toward securing the permit/any unauthorized changes are made to the site/any unauthorized changes are made in the installation of the system. Improvement Permit with plat valid without expiration. Improvement Permit with site plan valid for sixty months. Authorization to Construct is valid for a period equal to that of Improvement Permit – not to exceed sixty months.

Signed: * date 7/8/05 Installed by: Orlison

Improvement Permit by: Wesley Sparks RS. date 7/7/05 Operation Permit by: Wesley Sparks RS. date 11/23/05

Authorization to Construct by: Wesley Sparks RS date 7/7/05 Existing System Inspection by: date

HEALTH DEPT. COPY: WHITE OWNER COPY (FINAL): YELLOW OWNER COPY (INITIAL): PINK