IREDELL COUNTY HEALTH DEPARTMENT

Statesville Office (704) 878-5305 Mooresville Office (704) 660-3625 PERMIT # 21333

IMPROVEMENT PERMIT / AUTHORIZATION TO CONSTRUCT / OPERATION PERMIT / EXISTING SYSTEM

PIN # 4677502501

APPLICANT: Robert & Pam Bostian APPLICANT ADDRESS: 356 Brumley Mooresville, NC 28115

SITE ADDRESS: 356 Brumley Rd Mooresville, NC PHONE: ALT. PHONE: 704 664-4562

SITE DIRECTIONS: Hwy 152 E TR Brumley ~1 mile on right

SUBDIVISION: SECTION: LOT # LOT AREA: 18.13 Ac DESIGN FLOW: 480 gpd L.T.A.R.: .3

Existing

Septic Tank 1000 (gal) STB Date
Pump Tank (gal) PT Date
Pump Make Model Serial #
Nitrification Fields 1 # Lines 4 Linear Ft: 533'
Trench Width 36" Max. Trench Bottom Depth 36' Gravel Depth 12"

☐ New System ☐ Repair ☐ Expansion System Type: I II III IV V VI
System Description: Existing Gravity Conventional
Repair System Description: Same
Maintenance Agreement Required: ☐ YES ☒ NO
☒ GRAVITY ☐ PRESSURE


☒ Residence No. Bedrooms 4
☐ Business No. Persons 8
☒ Other Pool No. Employees
☐ Slab ☐ Crawl Space
☐ Basement w/plumbing ☐ Basement w/o plumbing

Water Supply: ☒ Private ☐ Public ☐ Community

Comments / Conditions:

The proposed inground pool does not appear to impact the existing Septic System.
* Must keep pool at least 15ft from Septic

INITIAL SITE SKETCH

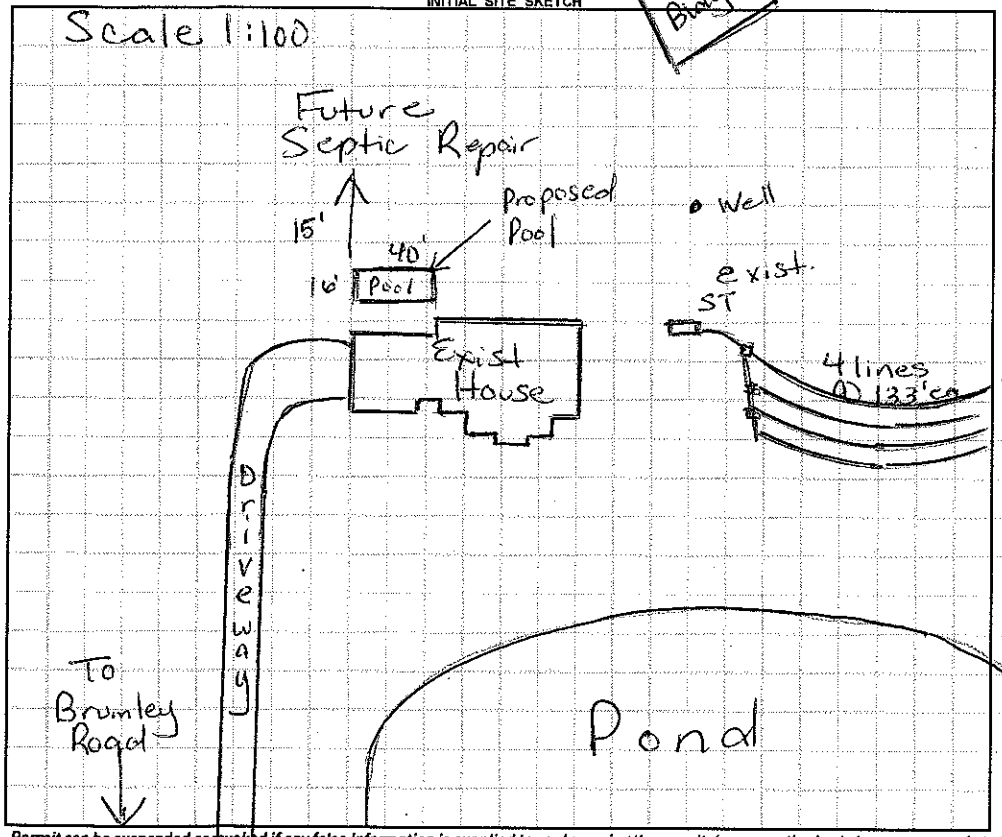

AS BUILT SKETCH

Permit can be suspended or revoked if any false information is supplied toward securing the permit / any unauthorized changes are made to the site / any unauthorized changes are made in the installation of the system. **CONTACT A LOCATOR SERVICE PRIOR TO ANY EXCAVATION**

☐ **IMPROVEMENT PERMIT** *with plat valid without expiration.* ☐ **IMPROVEMENT PERMIT** *with site plan valid for 60 mos.* ☐ **AUTHORIZATION TO CONSTRUCT** *valid for period equal to IMPROVEMENT PERMIT--not to exceed 60 mo.*

Owner / Applicant Signature: Pam Bostian Date: 10-5-15 Installed by:

IMPROVEMENT PERMIT by: Date: OPERATION PERMIT by: Date:

AUTHORIZATION TO CONSTRUCT by: Date: Existing System Inspected by: Mark Dotson RS Date: 10/2/15

Health Dept. Copy - WHITE Applicant (Final Approval) - YELLOW Applicant (Conditional Approval) - PINK