# IREDELL COUNTY HEALTH DEPARTMENT

STATESVILLE 704-878-5305 MOORESVILLE 704-664-5281

## IMPROVEMENT PERMIT / AUTHORIZATION TO CONSTRUCT / OPERATION PERMIT / EXISTING SYSTEM INSPECTION

PERMIT# 075930 PIN# ~~4677 51 3267~~ 4677 51 0425 DATE 9/24/98

OWNER OR CONTRACTOR ERIC METZ PHONE: Business Home

ADDRESS 139 BEECH TREE RD. MOORESVILLE RD. 28117

LOCATION HWY 152 - TR BRUMLEY - NEXT TO 300 BRUMLEY RD. ~ 700 FT OFF RD

SUBDIVISION — BLOCK / SECTION — LOT — LOT AREA 2.04C SITE CLASS. PS DESIGN FLOW 360GD L.T.A.R. .3000/FT²

Septic Tank: 1000 Gallons; STB 825 Date ~~9/11/98~~ 9/24/98

Pump Tank: Gallons; PT Date

Pump Make: Model Serial No.

Nitrification Field: No Fields 1 Square Feet 1200 Linear Feet 400

No Lines 4@100' Trench Width 36" Max Trench Bottom Depth 36" Gravel Depth 12"

☑ New System ☐ Repair System Type: I, II, III, IV, V, VI

System Description: GRAVITY CONVENTIONAL

Repair System Description: SAME

Maintenance Agreement Required: ☐ Yes ☑ No

☑ House/Mod. Home No. Bedrooms 3

☐ Mobile Home No. Bathrooms 2

☐ Business No. Employees

☐ Other

☐ Slab ☑ Crawl Space ☐ Basement w/plumbing ☐ Basement wo/plumbing


Water Supply: ☑ Individual ☐ Public ☐ Community

Comments:/Conditions:


Comments:/Conditions:

PJC

**INITIAL SITE SKETCH**

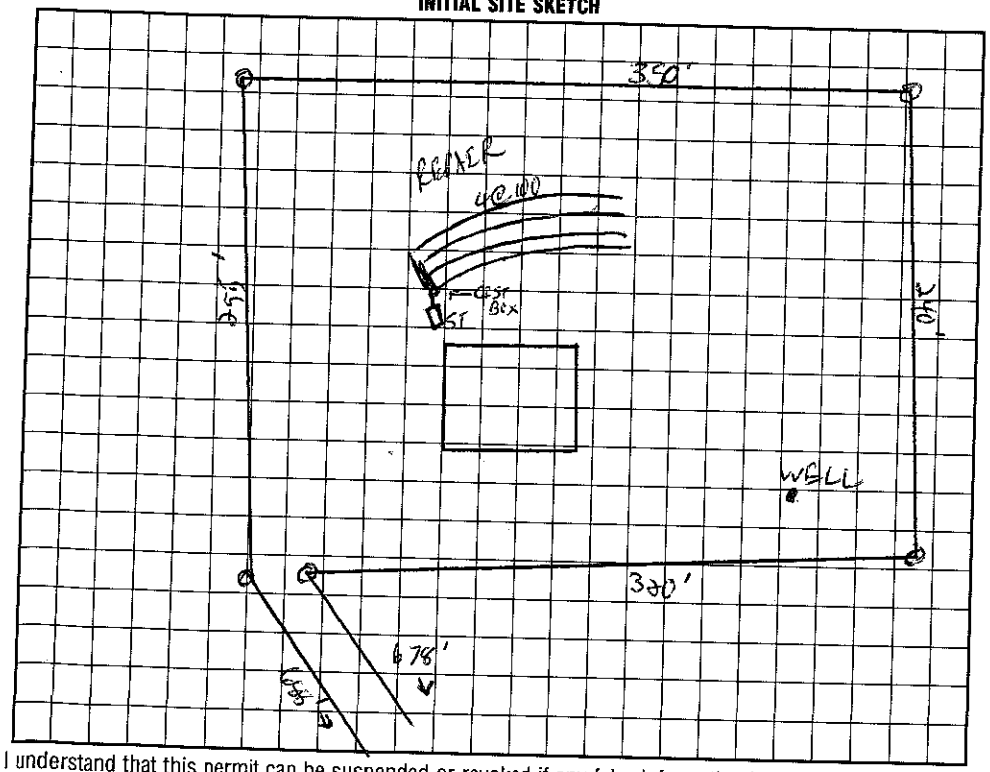


**AS BUILT SKETCH**

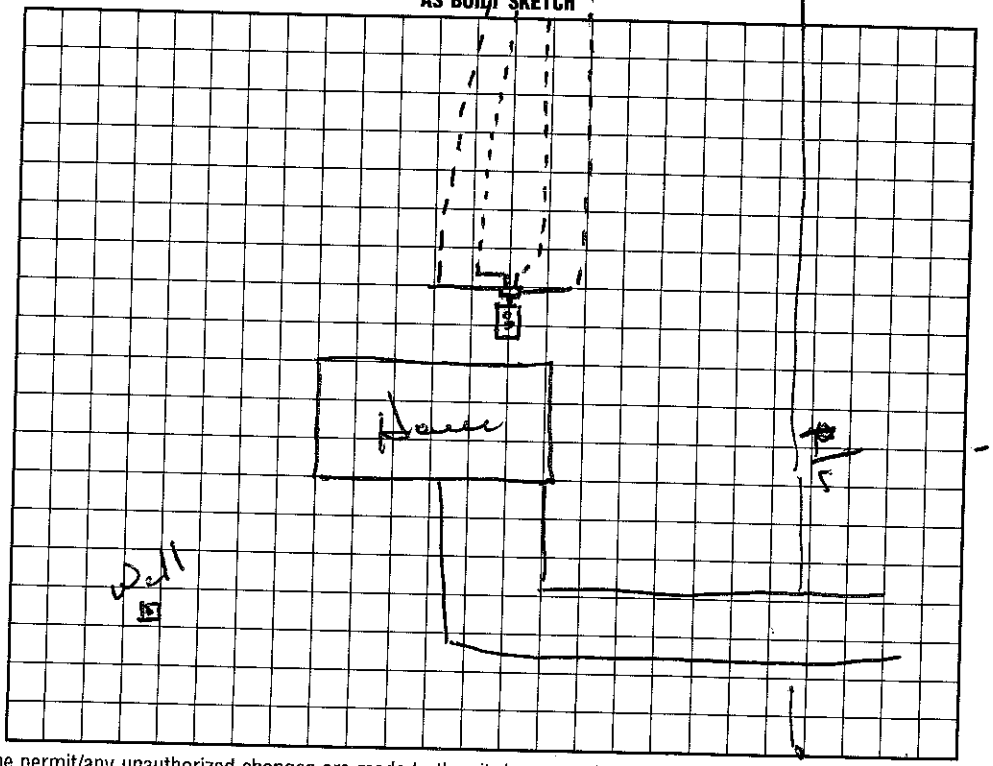


I understand that this permit can be suspended or revoked if any false information is supplied toward securing the permit/any unauthorized changes are made to the site/any unauthorized changes are made in the installation of the system. Improvement Permit with plat valid without expiration. Improvement Permit with site plan valid for sixty months. Authorization to Construct is valid for a period equal to that of Improvement Permit – not to exceed sixty months.

Signed: E. I. Metz date

Improvement Permit by: C. [illegible] RS date 9/24/98

Authorization to Construct by: C. [illegible] RS date 9/24/98

Installed by: Delbert Bostian

Operation Permit by: [illegible] RS. date 6/19/99

Existing System Inspection by: date

HEALTH DEPT. COPY: WHITE INSPECTION COPY (FINAL): GREEN OWNER COPY (FINAL): YELLOW INSPECTION COPY (INITIAL): PINK OWNER COPY (INITIAL): GOLD