IREDELL COUNTY HEALTH DEPARTMENT

4677578113

STATESVILLE 704-878-5305 MOORESVILLE 704-664-5281

10-10:15

IMPROVEMENT PERMIT / CERTIFICATE OF COMPLETION / OPERATION PERMIT / EXISTING SYSTEM INSPECTIO

PROPERTY DESCRIPTION NO. 066939 DATE 10/13/97 TAX MAP NO. 4677578113

OWNER OR CONTRACTOR 150 AUTO SALES PHONE: Business 663-4517 Home

ADDRESS 1332 OAK RIDGE FARM HWY MOORESVILLE NC 28115 Watershed: ☑ Yes ☐ No

LOCATION CORNER OF 150 - 152

SUBDIVISION — BLOCK / SECTION — LOT — LOT AREA 3.17AC SITE CLASS. AS DESIGN FLOW 240 L.T.A.R. .25

Septic Tank: 1000 Gallons; STB 794 Date 7/17/97

Pump Tank: Gallons; PT Date

Pump Make: Model Serial No.

Nitrification Field: No Fields 1 Square Feet 960 Linear Feet 320

No Lines 4@50' Trench Width 36" Max Trench Bottom Depth 36" Gravel Depth

☑ New System ☐ Repair System Type: I (II) III, IV, V, VI

System Description: GRAVITY CONVENTIONAL

Repair System Description: SAME

Maintenance Agreement Required: ☐ Yes ☑ No

☐ House/Mod. Home ☑ Mobile Home ☐ Business ☐ Other

No. Bedrooms 3 No. Bathrooms 2 No. Employees

☐ Slab ☑ Crawl Space ☐ Basement w/plumbing ☐ Basement wo/plumbing


Water Supply: ☑ Individual ☐ Community ☐ Public

Comments:


WELL UNDER GARAGE - 100 FT + TO SEPTIC AREA.

Comments:

INITIAL SITE SKETCH

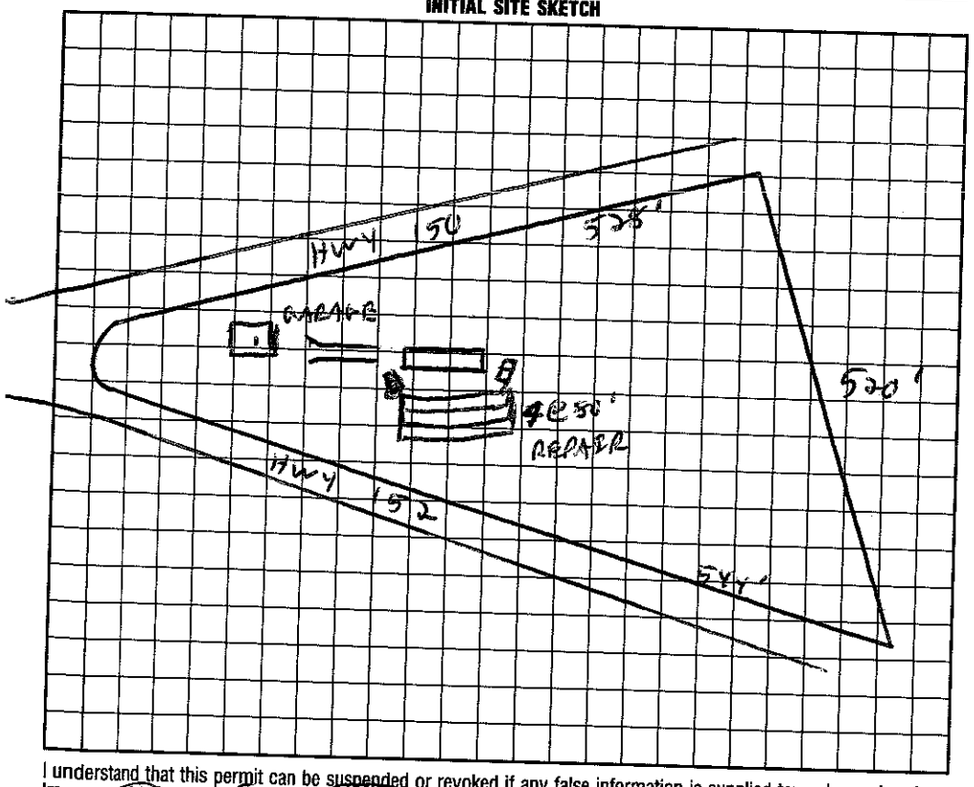

AS BUILT SKETCH

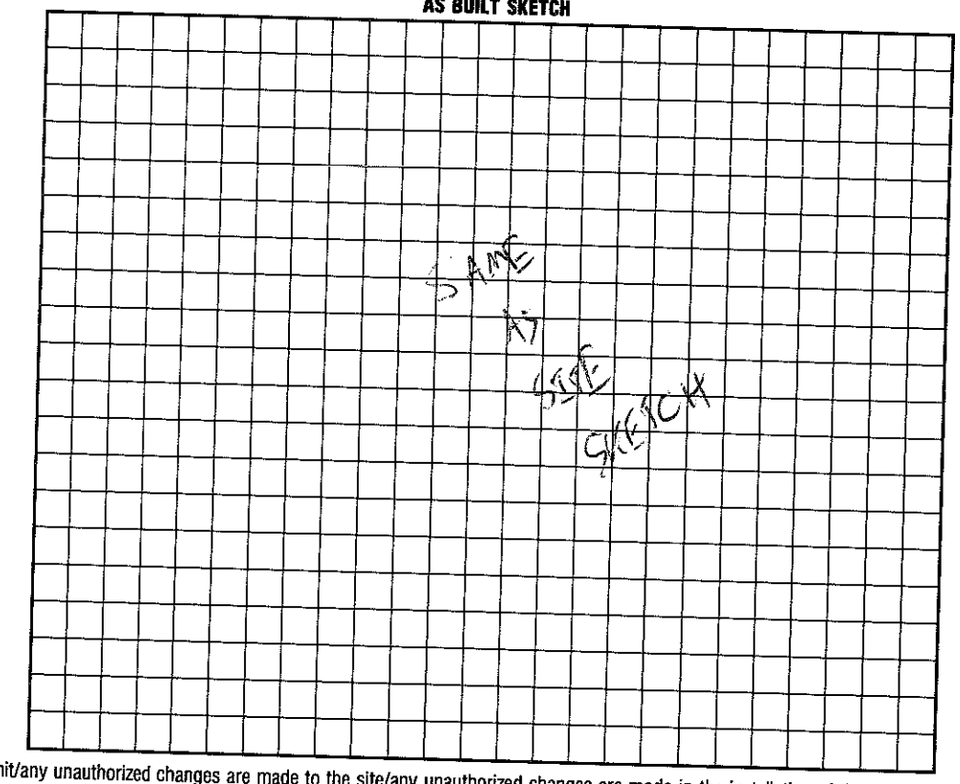

I understand that this permit can be suspended or revoked if any false information is supplied toward securing the permit/any unauthorized changes are made to the site/any unauthorized changes are made in the installation of the system. Improvement Permit is valid for 60 months from date of issuance.

Signed: David Dryden

Improvement Permit by: C. Brady Freeman date 10/13/97

Existing System Inspection by: C. Brady Freeman date 10/13/97

Installed by: ORBISON

Certificate of Completion by: date

Operation Permit by: C. Brady Freeman date 10/21/97

HEALTH DEPT. COPY: WHITE INSPECTION COPY (FINAL): GREEN OWNER COPY (FINAL): YELLOW INSPECTION COPY (INITIAL): PINK OWNER COPY (INITIAL): GOLD