IREDELL COUNTY HEALTH DEPARTMENT

Statesville Office (704) 878-5305 Mooresville Office (704) 660-3625 PERMIT # 216231

IMPROVEMENT PERMIT / AUTHORIZATION TO CONSTRUCT / OPERATION PERMIT / EXISTING SYSTEM

PIN # 4677-59-4168

APPLICANT: James C. Arthurs APPLICANT ADDRESS: 181 Oak Meadow Rd. Mooresville, NC

SITE ADDRESS: 181 Oak Meadow Rd. Mooresville, NC 28115 PHONE: 704-663-3331 ALT. PHONE:

SITE DIRECTIONS: Highway 150 East → Left on Oak Meadow Rd @ end of cul-da-sac.

SUBDIVISION: Oak Meadow SECTION: — LOT # 15 LOT AREA: 3.99 acres DESIGN FLOW: 360 gal/day L.T.A.R.: 0.35

Septic Tank 1250 Existing (gal) STB Date
Pump Tank (gal) PT Date
Pump Make Model Serial#
Nitrification Fields # Lines linear Ft:
Trench Width — Max. Trench Bottom Depth — Gravel Depth —

EXISTING


☐ New System ☐ Repair ☐ Expansion System Type: I II III IV V VI
System Description: EXISTING
Repair System Description:
Maintenance Agreement Required: ☐ YES ☒ NO
☒ GRAVITY ☐ PRESSURE

☒ Residence No. Bedrooms 3
☐ Business No. Persons 6
☐ Other No. Employees
☐ Slab ☐ Crawl Space
☐ Basement w/plumbing ☐ Basement w/o plumbing

Water Supply
☒ Private
☐ Public
☐ Community

Comments / Conditions: Recommend pumping septic tank every 3-5 years.

INITIAL SITE SKETCH

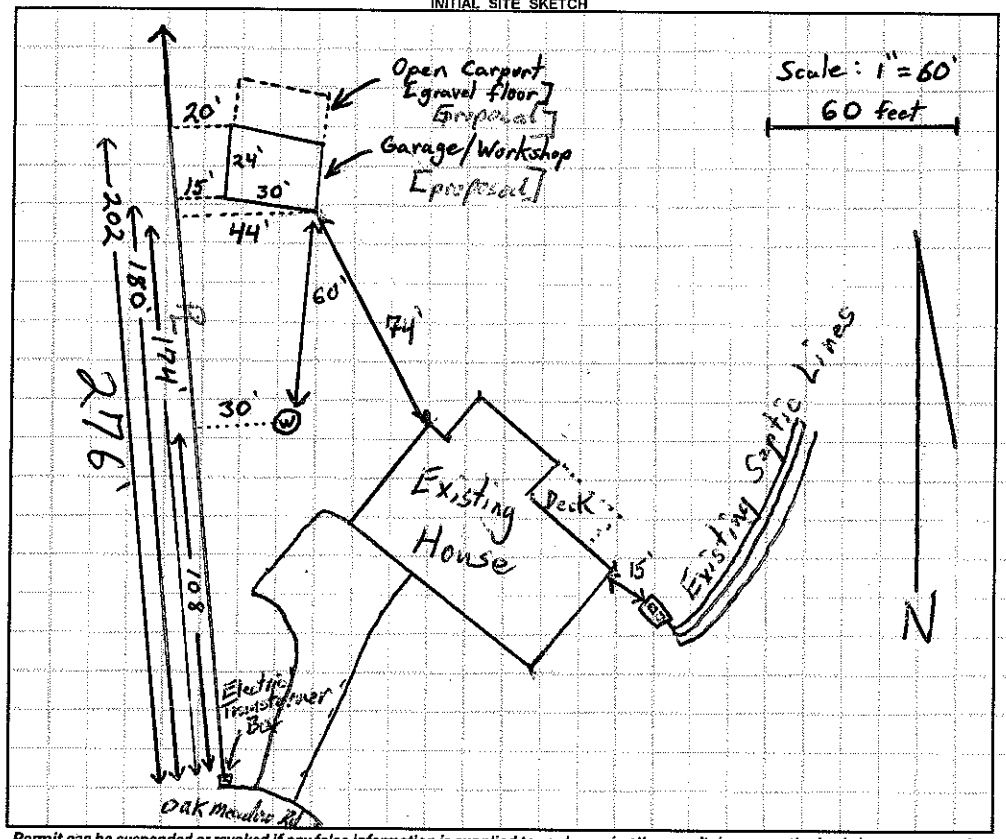

Scale: 1" = 60'
60 feet

AS BUILT SKETCH

Permit can be suspended or revoked if any false information is supplied toward securing the permit / any unauthorized changes are made to the site / any unauthorized changes are made in the installation of the system. **CONTACT A LOCATOR SERVICE PRIOR TO ANY EXCAVATION**


☐ **IMPROVEMENT PERMIT** *with plat valid without expiration.* ☐ **IMPROVEMENT PERMIT** *with site plan valid for 60 mos.* ☐ **AUTHORIZATION TO CONSTRUCT** *valid for period equal to IMPROVEMENT PERMIT--not to exceed 60 mo.*

Owner / Applicant Signature: James C Arthurs Date: 3-7-16 Installed by:

IMPROVEMENT PERMIT by: Date: OPERATION PERMIT by: Date:

AUTHORIZATION TO CONSTRUCT by: Date: Existing System Inspected by: Tom Shuck Date: 2-29-16

Health Dept. Copy - WHITE Applicant (Final Approval) - YELLOW Applicant (Conditional Approval) - PINK

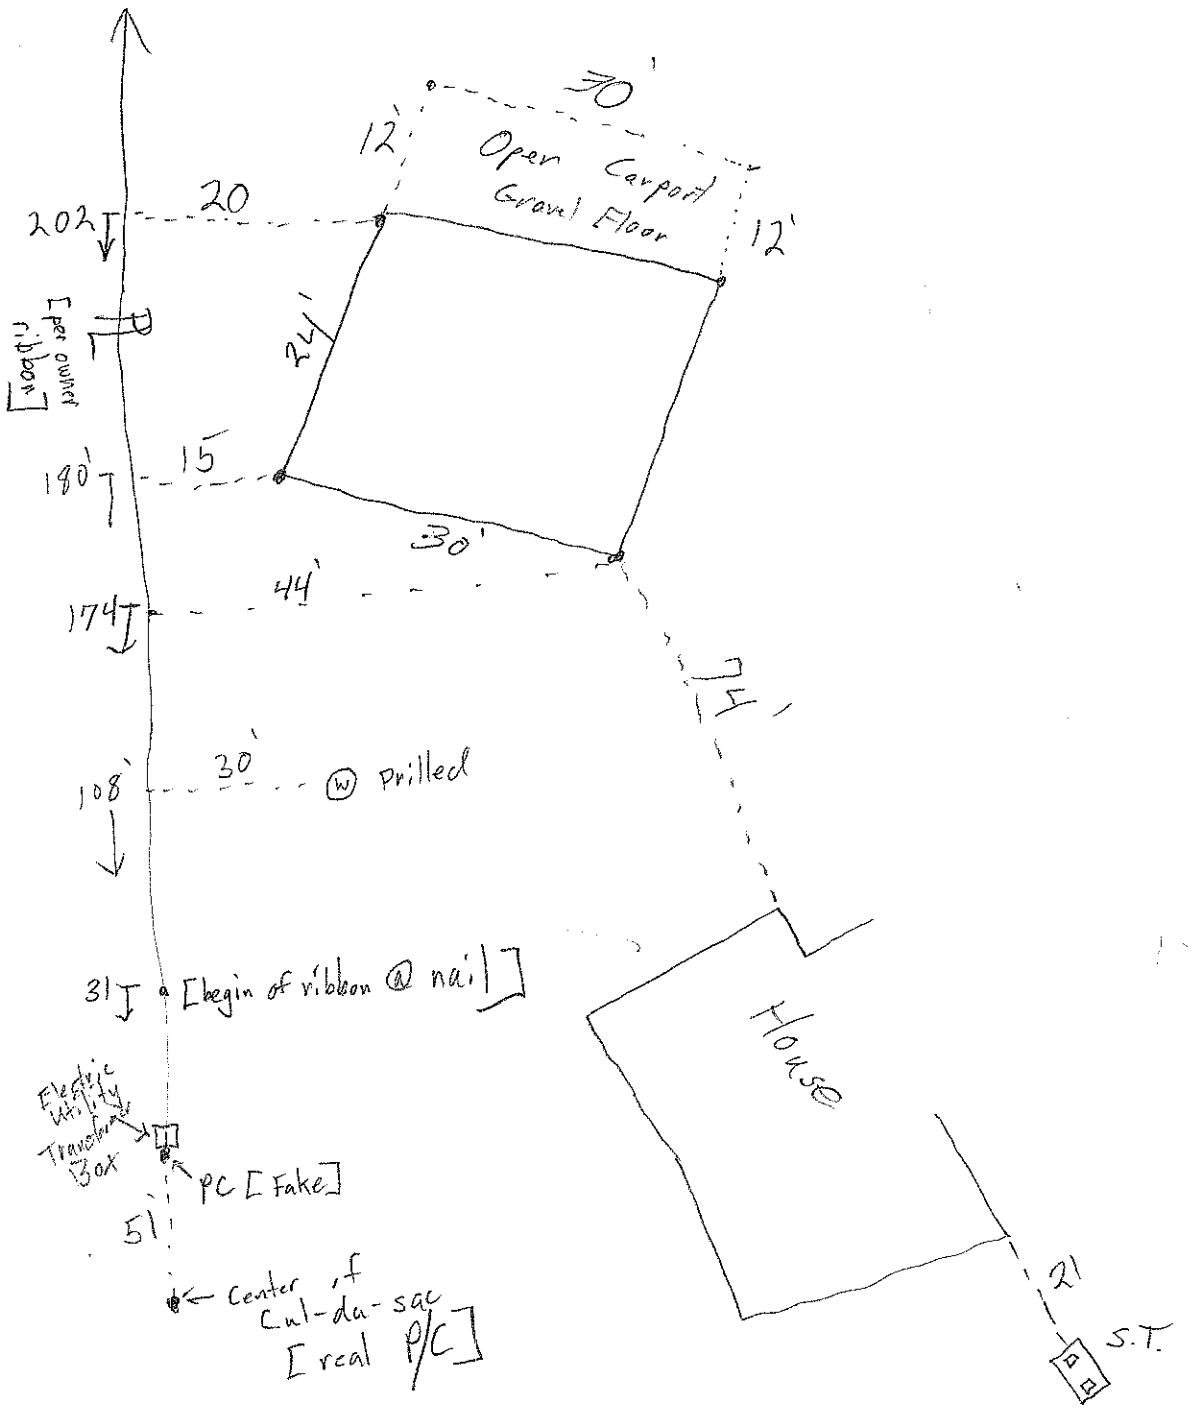
30'
12'
Open Carport
Gravel Floor
12'
20
202'
24'
[Top of ribbon]
[Per owner]
180'
15
30'
174'
44'
108'
30'
(W) Drilled
31'
[Begin of ribbon @ nail]
House
Electric Utility Transformer Box
PC [Fake]
51'
Center of Cul-de-sac [real P/C]
21
S.T.