IREDELL COUNTY HEALTH DEPARTMENT

Statesville Phone TR 3-7271 Mooresville Phone NO 3-1271

PERMIT TO INSTALL SEPTIC TANK

Permit NO. 243 Permit Date 10 - 31 - 1972

Owner mike Rice Address mooresville

Installed By orbisons Address mooresville


Location of Property 152 East to 1153 to 2mi Trailor on right.

Tank		Capacity		Length of Lines		Fixtures	
Block	( )	1000	(✓)	225'	(✓)	No. of Baths	(2)
Precast	(✓)	1250	( )	250'	( )	Dishwasher	(no)
		1500	( )	Other		Garbage Grdr.	(no)
		Other				Other	washing machine

NOTIFY HEALTH DEPARTMENT AT LEAST EIGHT HOURS BEFORE TANK IS TO BE INSPECTED.

Final Inspection 10-31-1972 Approved (✓) Disapproved ( )

Remarks For 1 Trailor only

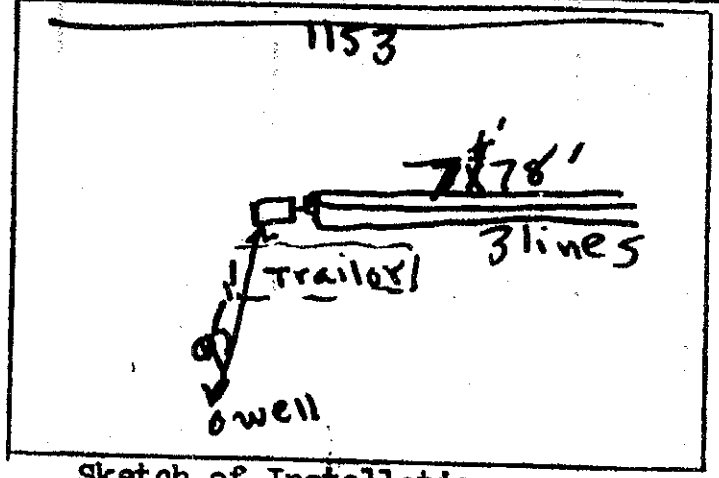

Sketch of Installation

J. C. moore

Sanitarian