[redacted] 130

IREDELL COUNTY HEALTH DEPARTMENT

STATESVILLE 704-878-5305 MOORESVILLE 704-634-5281

IMPROVEMENT PERMIT / AUTHORIZATION TO CONSTRUCT / OPERATION PERMIT / EXISTING SYSTEM INSPECTION

PERMIT# ~~20K 9903~~ 2008 2027 PIN# 4677 61 3727 DATE 6/8/99

OWNER OR CONTRACTOR BRYAN FREEZE PHONE: Business 872-0192 Home

ADDRESS 1524 Beech Circle Wilkesboro, NC 28697

LOCATION 1.50E TR 1532 TR BRUMLEY RD. ~ 1 MILE ON (L) SCHOOL HOUSE LANE

SUBDIVISION BLOCK / SECTION LOT LOT AREA 1.48AC SITE CLASS. PS DESIGN FLOW 480 L.T.A.R. .3

Septic Tank: 1000 Gallons; STB 284 Date 3/3/00

Pump Tank: ~~1000~~ Gallons; PT Date

Pump Make: Model Serial No.

Nitrification Field: No Fields 1 Square Feet 1600 Linear Feet 533

No Lines 5@106' x3' Trench Width 36" Max ~~Trench Bottom~~ Depth 36" Gravel Depth 12"

[X] New System [ ] Repair System Type: I, [II] III, IV, V, VI

System Description: BEAV - CONVENTIONAL

Repair System Description: SAME

Maintenance Agreement Required: [ ] Yes [X] No

[X] House/Mod. Home No. Bedrooms 4

[ ] Mobile Home No. Bathrooms 3

[ ] Business No. Employees

[ ] Other


[ ] Slab [X] Crawl Space [ ] Basement w/plumbing [ ] Basement wo/plumbing

Water Supply: [X] Individual [ ] Public [ ] Community

Comments:/Conditions:


(1"=50')

INITIAL SITE SKETCH

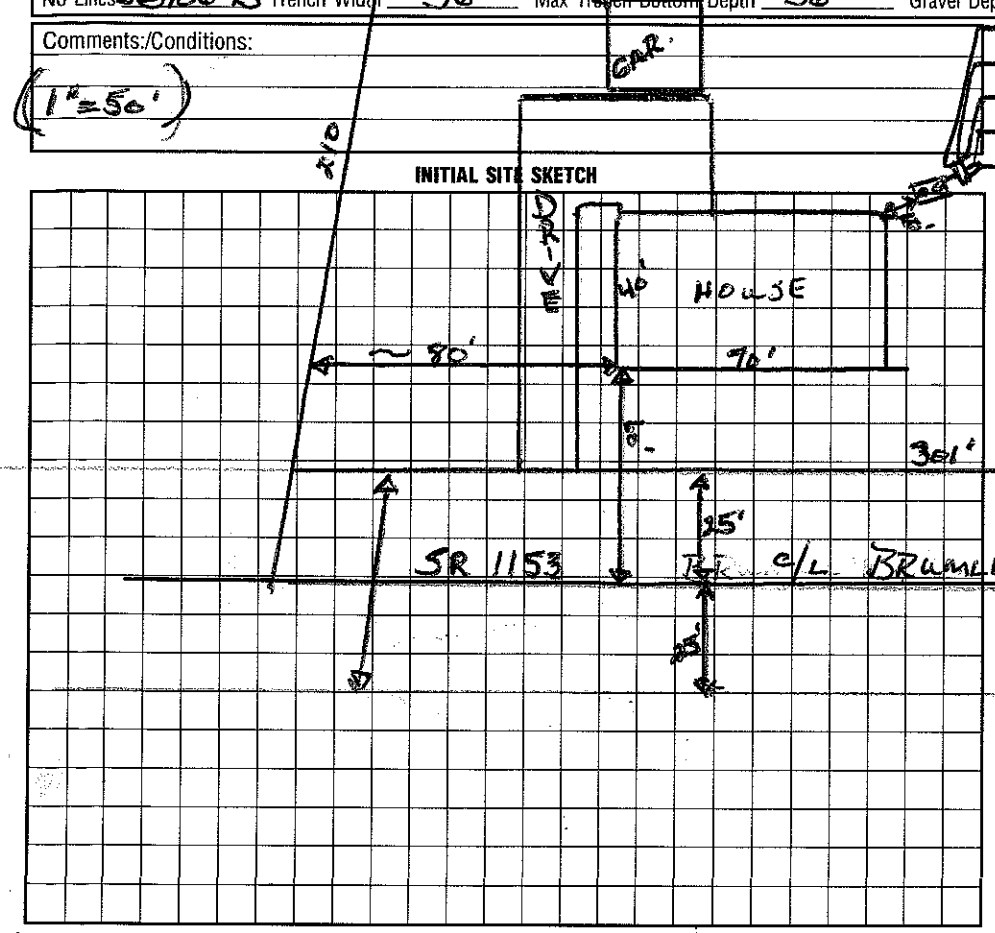

Comments:/Conditions:

AS BUILT SKETCH

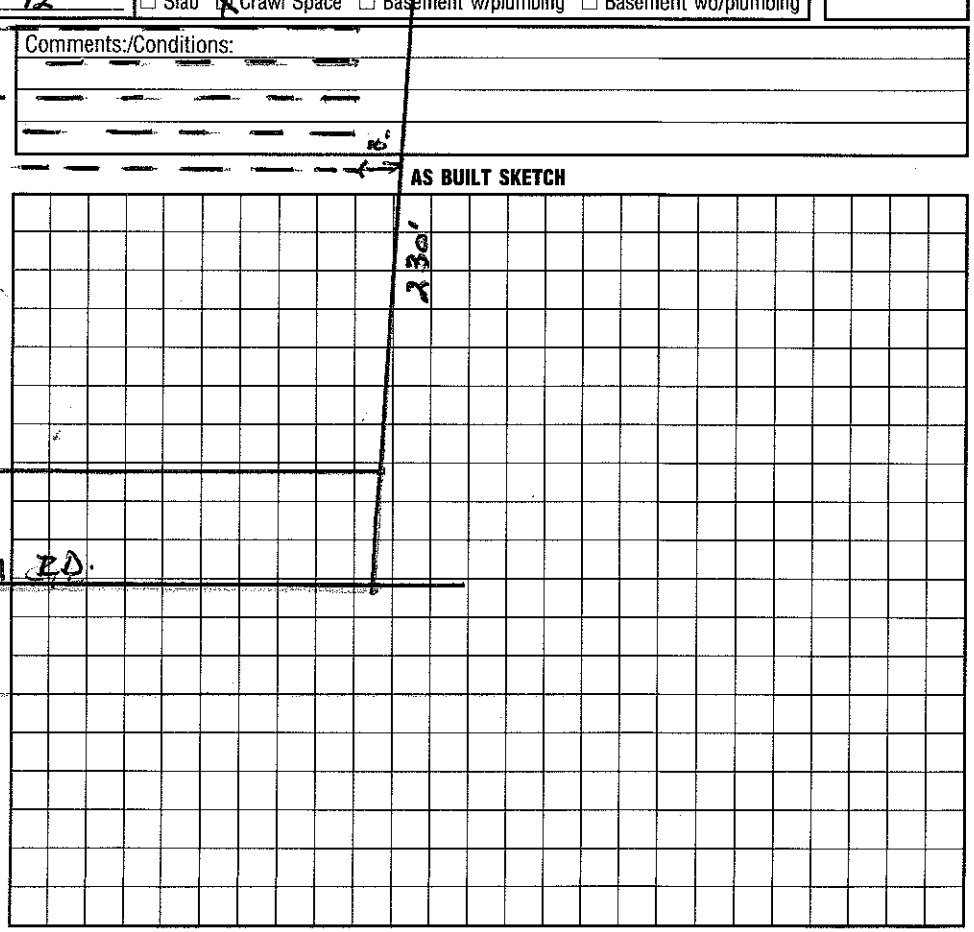

I understand that this permit can be suspended or revoked if any false information is supplied toward securing the permit/any unauthorized changes are made to the site/any unauthorized changes are made in the installation of the system. Improvement Permit with plat valid without expiration. Improvement Permit with site plan valid for sixty months. Authorization to Construct is valid for a period equal to that of Improvement Permit – not to exceed sixty months.

Signed: X Bryan Freeze date 6/14/99

Improvement Permit by: Wesley Sparks RS. date 6/8/99

Authorization to Construct by: Wesley Sparks RS. date 6/8/99

Installed by: Blackburn & Sons date

Operation Permit by: Mark H. Dobson RS date 5/24/2000

Existing System Inspection by: date

HEALTH DEPT. COPY: WHITE INSPECTION COPY (FINAL): GREEN OWNER COPY (FINAL): YELLOW INSPECTION COPY (INITIAL): PINK OWNER COPY (INITIAL): GOLD