IREDELL COUNTY HEALTH DEPARTMENT

Qu[illegible]uct 4677627263

STATESVILLE 704-878-5305 MOORESVILLE 704-664-5281

IMPROVEMENT PERMIT / ~~CERTIFICATE OF COMPLETION~~ / OPERATION PERMIT / EXISTING SYSTEM INSPECTION

PROPERTY DESCRIPTION NO. 23475 DATE 5/28/96 TAX MAP NO. 16A57 Watershed: X Yes ☐ No

OWNER OR CONTRACTOR Bingham Hefner PHONE: Business

ADDRESS 9725 Mt. Holly-Huntersville Rd. Huntersville, NC. 28078 Home 399-0929

LOCATION 152 TR on Brumley Rd. ~ 3/4 mile on (L)

SUBDIVISION N/A BLOCK / SECTION LOT LOT AREA ~6.88AC SITE CLASS. PS DESIGN FLOW 360 L.T.A.R. 3

Septic Tank: 1000 Gallons; STB 794 Date 4/15/96

Pump Tank: Gallons; PT Date

Pump Make: Model Serial No.

Nitrification Field: No Fields 1 Square Feet 1200 Linear Feet 400

No Lines 4 Trench Width 36" Max Trench Bottom Depth 36" Gravel Depth 12"

X New System ☐ Repair System Type: I (II) III. IV. V. VI

System Description: CONV - DIST BOX

Repair System Description:

Maintenance Agreement Required: ☐ Yes X No

X House/Mod. Home ☐ Mobile Home ☐ Business ☐ Other

No. Bedrooms 3 No. Bathrooms 2 No. Employees


☐ Slab ☐ Crawl Space X Basement w/plumbing ☐ Basement wo/plumbing

Water Supply: X Individual ☐ Community ☐ Public

Comments:

Comments:

INITIAL SITE SKETCH

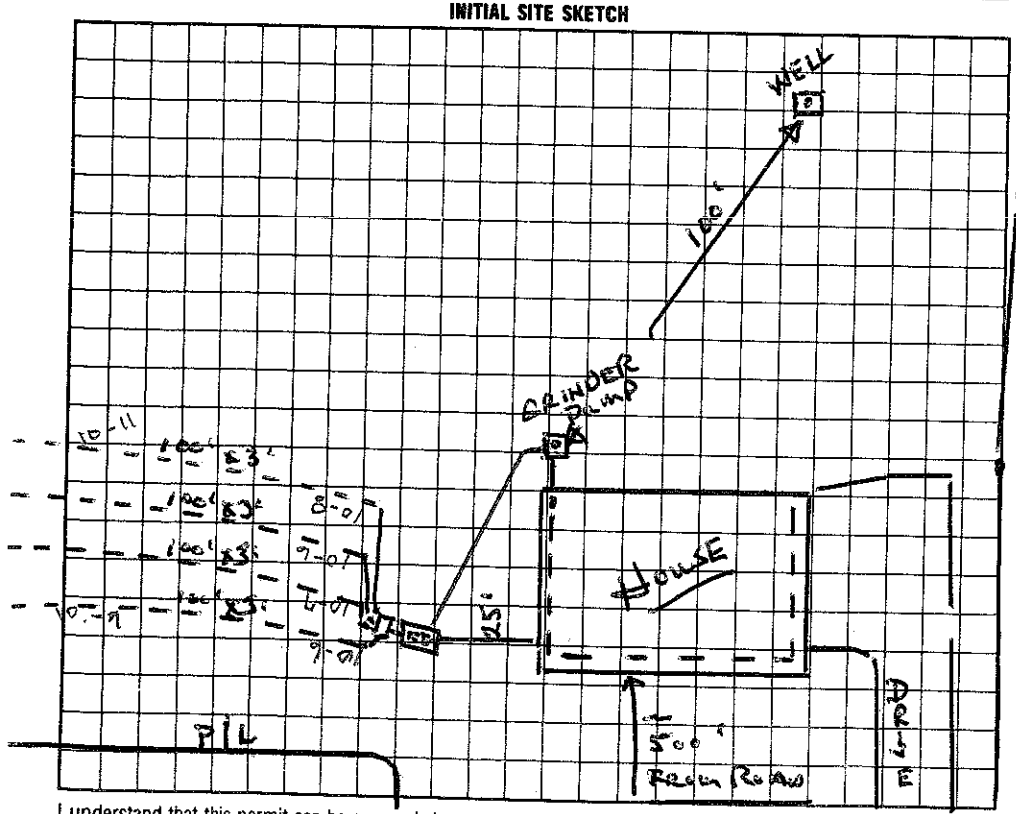

AS BUILT SKETCH

I understand that this permit can be suspended or revoked if any false information is supplied toward securing the permit/any unauthorized changes are made to the site/any unauthorized changes are made in the installation of the system.

Signed: X Bingham Hefner

Improvement Permit by: Wesley Sparks RS. date 5/28/96

Existing System Inspection by: Wesley Sparks RS. date 5/28/96

Installed by: Bingham Hefner

Certificate of Completion by: date

Operation Permit by: Wesley Sparks RS. date 9/26/96

HEALTH DEPT. COPY: WHITE INSPECTION COPY (FINAL): GREEN OWNER COPY (FINAL): YELLOW INSPECTION COPY (INITIAL): PINK OWNER COPY (INITIAL): GOLD