(T Thomas Sowers)

IREDELL COUNTY HEALTH DEPARTMENT

Ret. for Action to Construct

STATESVILLE 704-878-5305 MOORESVILLE 704-664-5281

IMPROVEMENT PERMIT / ~~CERTIFICATE OF COMPLETION~~ / OPERATION PERMIT / EXISTING SYSTEM INSPECTION

PROPERTY DESCRIPTION NO. 23055 DATE 3/1/96 TAX MAP NO. 1G-A-4 4677 62 9921 Watershed: ☐ Yes ☒ No

OWNER OR CONTRACTOR ~~Rodney Kendrick Builders~~ PHONE: Business _____ Home 617-933-6059

ADDRESS Woburn Mass. 01801

LOCATION Bramley Rd. - 150 East TR Hwy 152 TR Bramley Rd. ~ .5 mile on (L) 205 Bramley Rd

SUBDIVISION N/A BLOCK / SECTION _____ LOT _____ LOT AREA ~3 AC SITE CLASS. PS DESIGN FLOW 480 L.T.A.R. .2

Septic Tank: 1000 Gallons; STB 794 Date 11/16/96

Pump Tank: 1000 Gallons; PT 27 Date 11/23/96

Pump Make: HYDROMATIC Model SHEF50A1 Serial No. 3498 + 600

Nitrification Field: No. Fields 1 Square Feet 2400 Linear Feet (800)

No. Lines 6 Trench Width 36" Max Trench Bottom Depth 18" Gravel Depth 6" SAND

☒ New System ☐ Repair System Type: I. II. (III) IV. V. VI

System Description: ULTRA SHALLOW CHAMBERED PLASTIC

Repair System Description: SAME

Maintenance Agreement Required: ☐ Yes ☐ No

☐ House/Mod. Home ☐ Mobile Home ☐ Business ☐ Other

No. Bedrooms 4 No. Bathrooms 2.5 No. Employees ____


☐ Slab ☐ Crawl Space ☒ Basement w/plumbing ☐ Basement wo/plumbing

Water Supply: ☒ Individual ☐ Community ☐ Public


Comments: * Chambered Plastic from Pressure Manifold - Additional 6-8" soil required 6" Sand required to top of louvers on each section of drainfield

Comments:

INITIAL SITE SKETCH

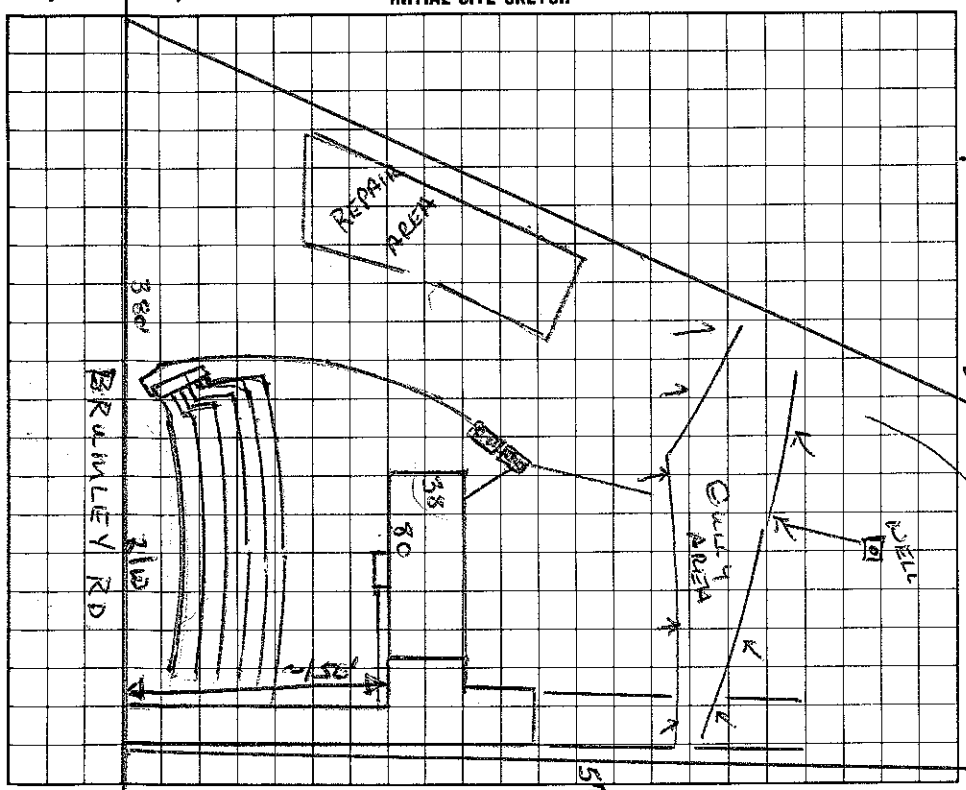

AS BUILT SKETCH

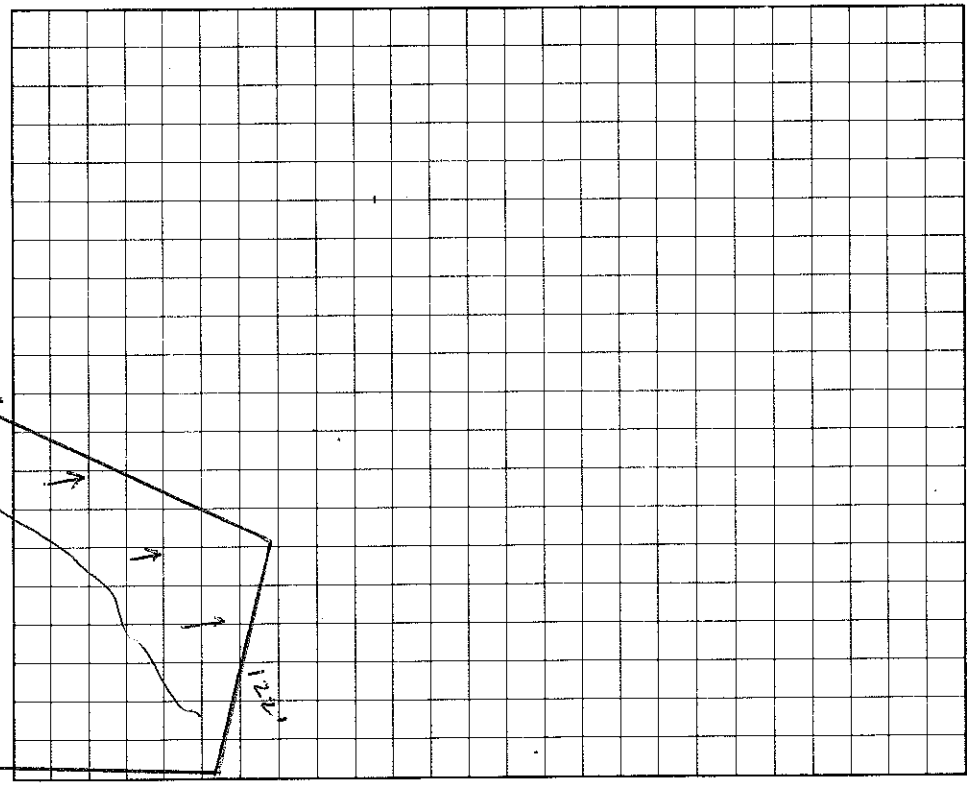

I understand that this permit can be suspended or revoked if any false information is supplied toward securing the permit/any unauthorized changes are made to the site/any unauthorized changes are made in the installation of the system.

Authorization to Construct valid for 5 years.

Signed: _____

Improvement Permit by: Wesley Sparks RS. date 3/4/96

Existing System Inspection by: Wesley Sparks RS. date 3/4/96

Installed by: Ray Beam

Certificate of Completion by: Wesley Sparks RS. date 1/28/97

Operation Permit by: Wesley Sparks RS. date 1/28/97

Authorization to Construct

HEALTH DEPT. COPY: WHITE INSPECTION COPY (FINAL): GREEN OWNER COPY (FINAL): YELLOW INSPECTION COPY (INITIAL): PINK OWNER COPY (INITIAL): GOLD