IREDELL COUNTY HEALTH DEPARTMENT

Statesville Office (704) 878-5305 Mooresville Office (704) 660-3625 PERMIT # 179684

IMPROVEMENT PERMIT / AUTHORIZATION TO CONSTRUCT / OPERATION PERMIT / EXISTING SYSTEM

PIN # 4677637603-6631

APPLICANT: MICHAEL YOUNG APPLICANT ADDRESS: 221 FOXTRAX DR

SITE ADDRESS: 202 BRUMLEY RD MOORESVILLE NC 28115 PHONE: ALT. PHONE: 704-664-2774

SITE DIRECTIONS: MAIN ST- TR LINWOOD - TL BRUMLEY - ON LT

SUBDIVISION: — SECTION: — LOT # — LOT AREA: .8AC DESIGN FLOW: 360 L.T.A.R.: .3

Septic Tank 1000 (gal) STB 11-24-14 Date 825
Pump Tank 1000 (gal) PT 10-20-14 Date 302
Pump Make ZOELLER Model N152 Serial #
Nitrification Fields 1 # Lines 4 Linear Ft: 300
Trench Width 36" Max. Trench Bottom Depth 36" Gravel Depth N/A


☑ New System ☐ Repair ☐ Expansion System Type: I II (III) IV V VI
System Description: PUMP 25% REDUCTION
Repair System Description: LP [redacted] 25% SHALLOW PLACED
Maintenance Agreement Required: ☐ YES ☑ NO
☐ GRAVITY ☑ PRESSURE

☑ Residence No. Bedrooms 3
☐ Business No. Persons 6
☐ Other No. Employees
☐ Slab ☐ Crawl Space
☑ Basement w/plumbing ☐ Basement w/o plumbing

Water Supply: ☑ Private ☐ Public ☐ Community

Comments / Conditions:

INITIAL SITE SKETCH

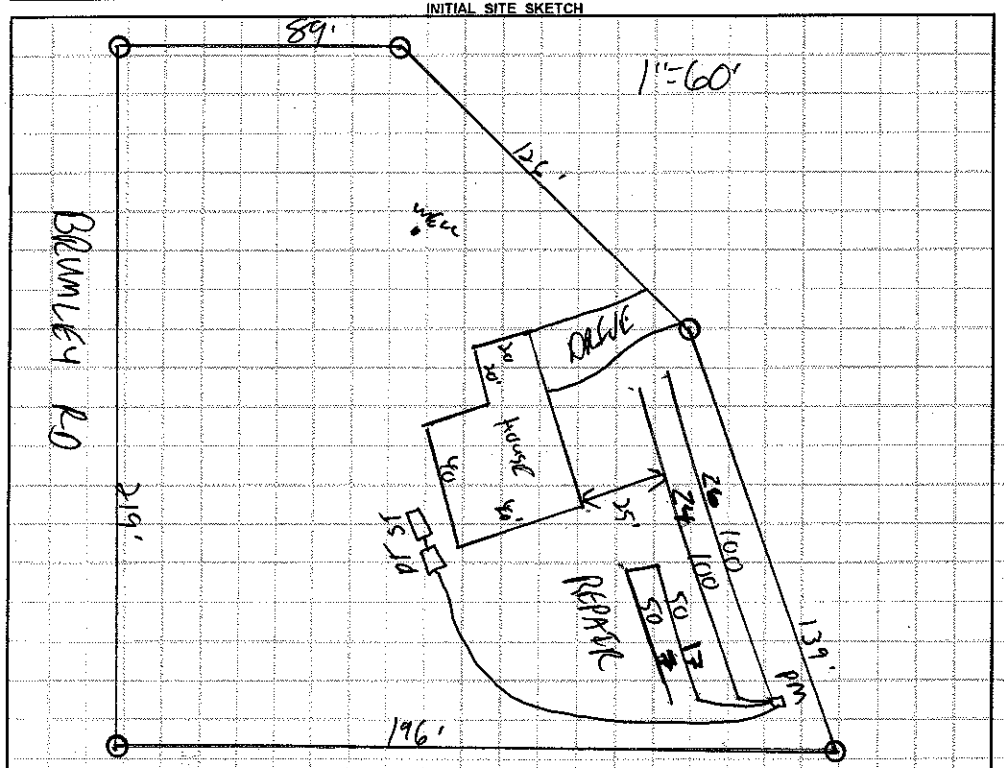

AS BUILT SKETCH

SET 2 \ PH
CHECKED LINES
&
TANKS
1-27-14

CHECKED ELEC.

APPROVED FEB 06 2015

Permit can be suspended or revoked if any false information is supplied toward securing the permit / any unauthorized changes are made to the site / any unauthorized changes are made in the installation of the system. **CONTACT A LOCATOR SERVICE PRIOR TO ANY EXCAVATION**

☐ **IMPROVEMENT PERMIT** *with plat valid without expiration.* ☐ **IMPROVEMENT PERMIT** *with site plan valid for 60 mos.* ☐ **AUTHORIZATION TO CONSTRUCT** *valid for period equal to IMPROVEMENT PERMIT--not to exceed 60 mo.*

Owner / Applicant Signature: Date: 4-7-14 Installed by: ROWAN

IMPROVEMENT PERMIT by: Date: 10/16/13 OPERATION PERMIT by: APPROVED FEB 06 2015 Date:

AUTHORIZATION TO CONSTRUCT by: Date: 4/7/14 Existing System Inspected by: Date:

Health Dept. Copy - WHITE Applicant (Final Approval) - YELLOW Applicant (Conditional Approval) - PINK