IREDELL COUNTY HEALTH DEPARTMENT

STATESVILLE 704-878-5305 MOORESVILLE 704-664-5281

IMPROVEMENT PERMIT / CERTIFICATE OF COMPLETION / OPERATION PERMIT / EXISTING SYSTEM INSPECTION

PROPERTY DESCRIPTION NO. 22977 DATE 1/25/96

OWNER OR CONTRACTOR Richard P Walker TAX MAP NO. 1P-1-A-16

ADDRESS 193 Pine Ridge Dr. Mooresville, NC. 28115 PHONE: Business No Watershed: X Yes ☐ No

LOCATION 150 E TL Pineridge Dr. to end then on Cul de sac Home ~~44-78-80-2181~~ 4677-69-2674

SUBDIVISION ~~Pine Ridge~~ BLOCK / SECTION LOT 16 LOT AREA 6.2 Ac. SITE CLASS. PS DESIGN FLOW 360 L.T.A.R.

~~MVILLE COUNTRY ESTATES~~

Septic Tank: Existing Gallons; STB Date

Pump Tank: 0 Gallons; PT Date

Pump Make: Model Serial No.

Nitrification Field: No Fields Square Feet ~~Existing System~~ Linear Feet

No Lines 2 Trench Width Max Trench Bottom Depth Gravel Depth

☐ New System ☐ Repair System Type: I II III IV V VI

System Description: Existing System

Repair System Description:

Maintenance Agreement Required: ☐ Yes X No

X House/Mod. Home No. Bedrooms 3

☐ Mobile Home No. Bathrooms 2

☐ Business No. Employees

☐ Other


☐ Slab ☐ Crawl Space ☐ Basement w/plumbing ☐ Basement wo/plumbing

Water Supply:
X Individual
☐ Community
☐ Public


Comments:

Comments:

INITIAL SITE SKETCH

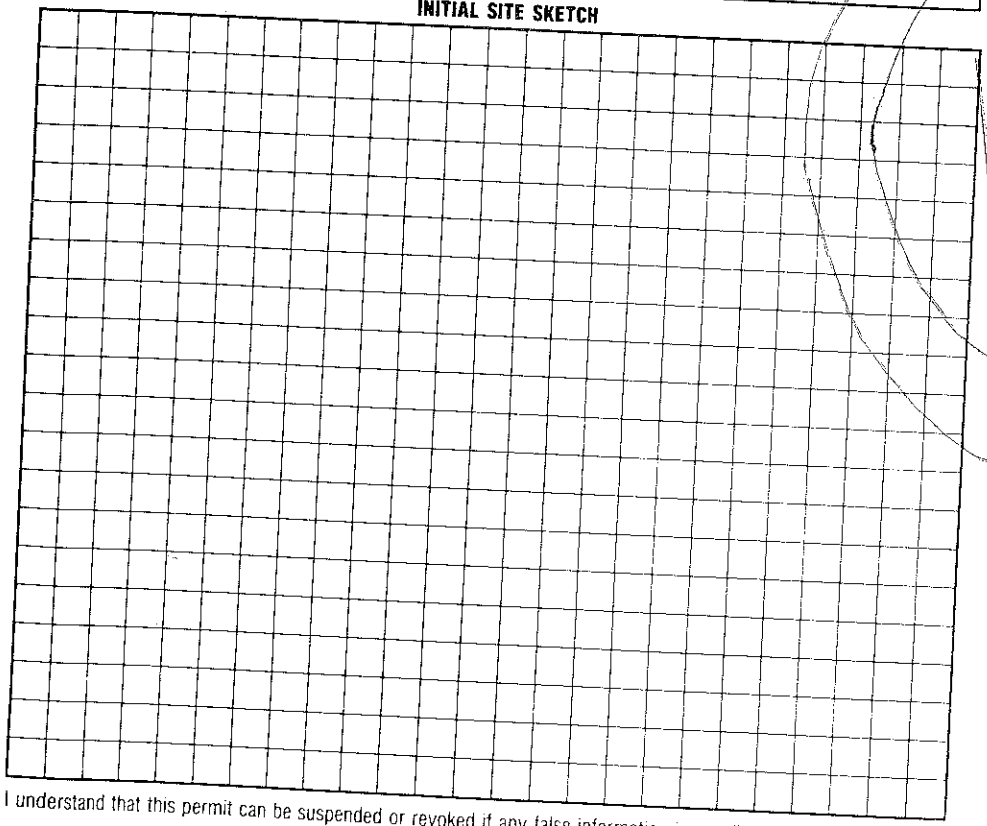

AS BUILT SKETCH

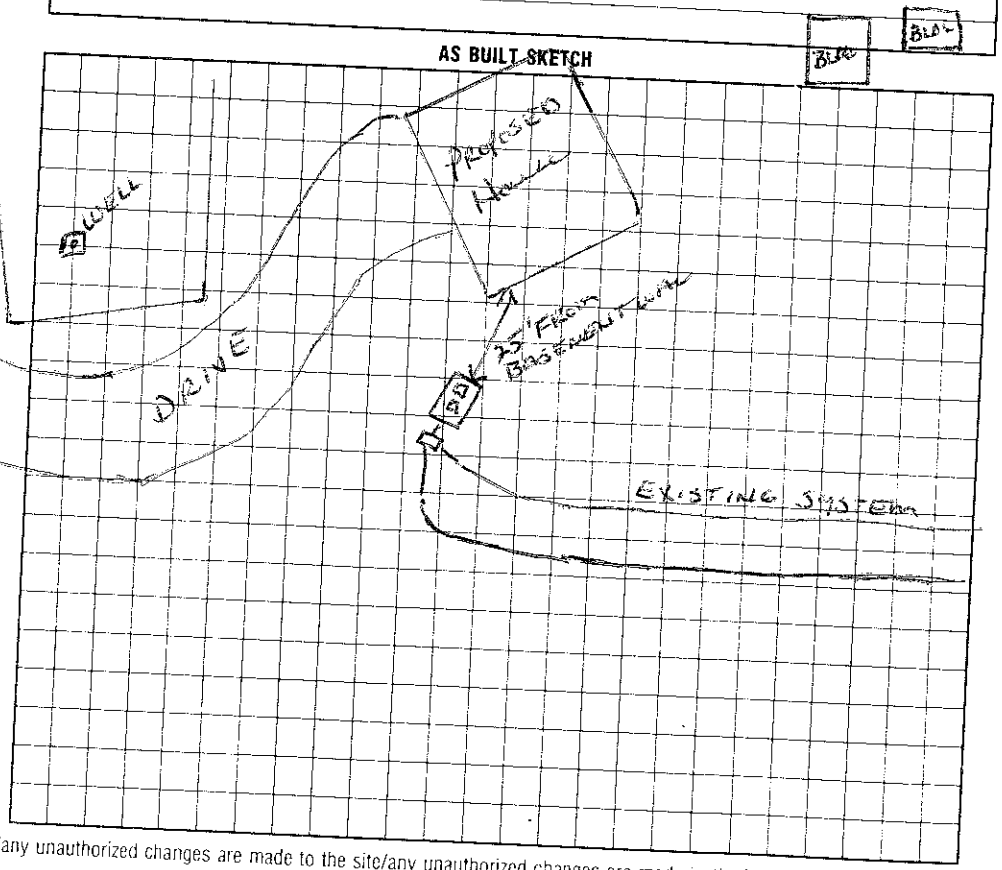

I understand that this permit can be suspended or revoked if any false information is supplied toward securing the permit/any unauthorized changes are made to the site/any unauthorized changes are made in the installation of the system.

Signed:

Improvement Permit by: Installed by:

Existing System Inspection by: date

Certificate of Completion by: Wesley Sparks RS. date 1/25/96

Operation Permit by: Wesley Sparks RS. date 1/25/96

HEALTH DEPT. COPY: WHITE INSPECTION COPY (FINAL): GREEN OWNER COPY (FINAL): YELLOW INSPECTION COPY (INITIAL): PINK OWNER COPY (INITIAL): GOLD