IREDELL COUNTY HEALTH DEPARTMENT

ST[illegible]LLE 704-878-5305 MOORESVILLE 704-664-5281

IMPROVEMENT PERMIT / CERTIFICATE OF COMPLE[illegible]ION / OPERATION PERMIT / EXISTING SYSTEM INSPECTION

PROPERTY DESCRIPTION NO. 25334 DATE 10/31/96 TAX MAP NO. 1P 1A 18 Watershed: X Yes ☐ No

OWNER OR CONTRACTOR JOAN ~~John~~ Chapman PHONE: Business 4077-69-8756 Home 663-5265

ADDRESS 163 Pineridge Dr. Mooresville NC. 28115

LOCATION 150E TL Pineridge Dr. #163 on L

SUBDIVISION MRSVL COUNTRY ESTATES BLOCK / SECTION ____ LOT 18 LOT AREA 5.49Ac SITE CLASS. PS DESIGN FLOW 360 L.T.A.R. .35

Septic Tank: EXISTING Gallons; STB ____ Date ____

Pump Tank: ____ Gallons; PT ____ Date ____

Pump Make: ____ Model ____ Serial No. ____

Nitrification Field: No Fields 1 Square Feet 240 Linear Feet 80'

No Lines 1 Trench Width 36" Max Trench Bottom Depth 36" Gravel Depth 12"

☐ New System X Repair System Type: I, II, III, IV, V, VI

System Description: ADD DRAINLINE

Repair System Description: ____

Maintenance Agreement Required: ☐ Yes ☐ No

X House/Mod. Home ☐ Mobile Home ☐ Business ☐ Other

No. Bedrooms 3 No. Bathrooms 2 No. Employees ____


☐ Slab ☐ Crawl Space X Basement w/plumbing X Basement wo/plumbing

Water Supply: X Individual ☐ Community ☐ Public


Comments: Install sewer line as shown 70' and 1 drainline 80' x 3'

Comments:

INITIAL SITE SKETCH

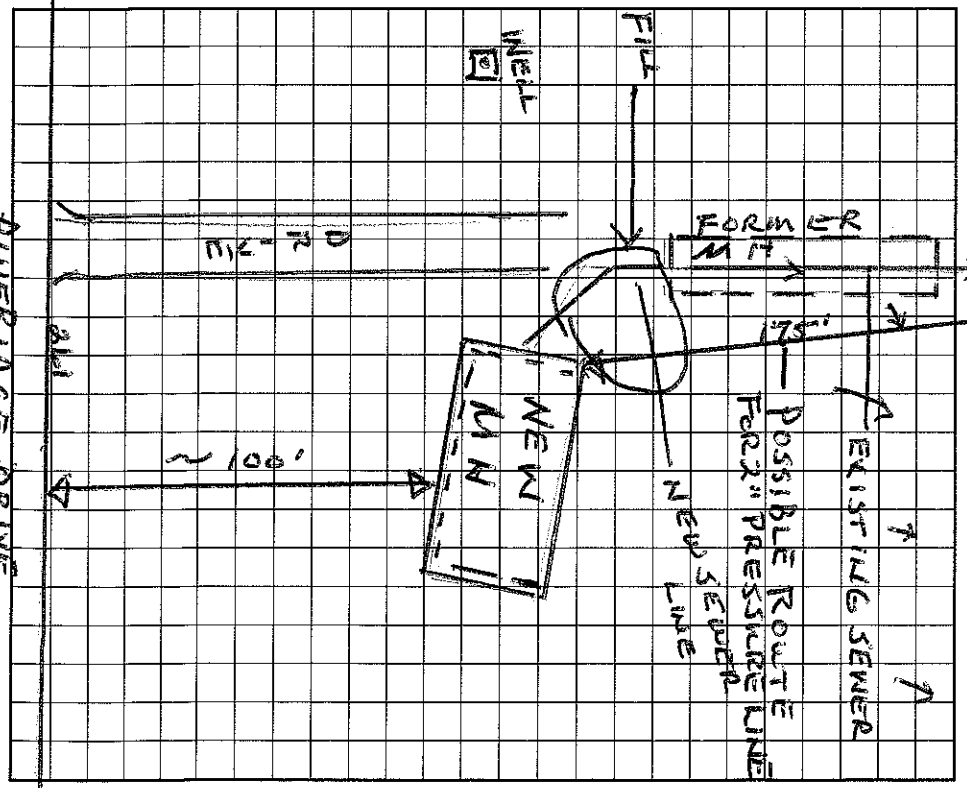

AS BUILT SKETCH

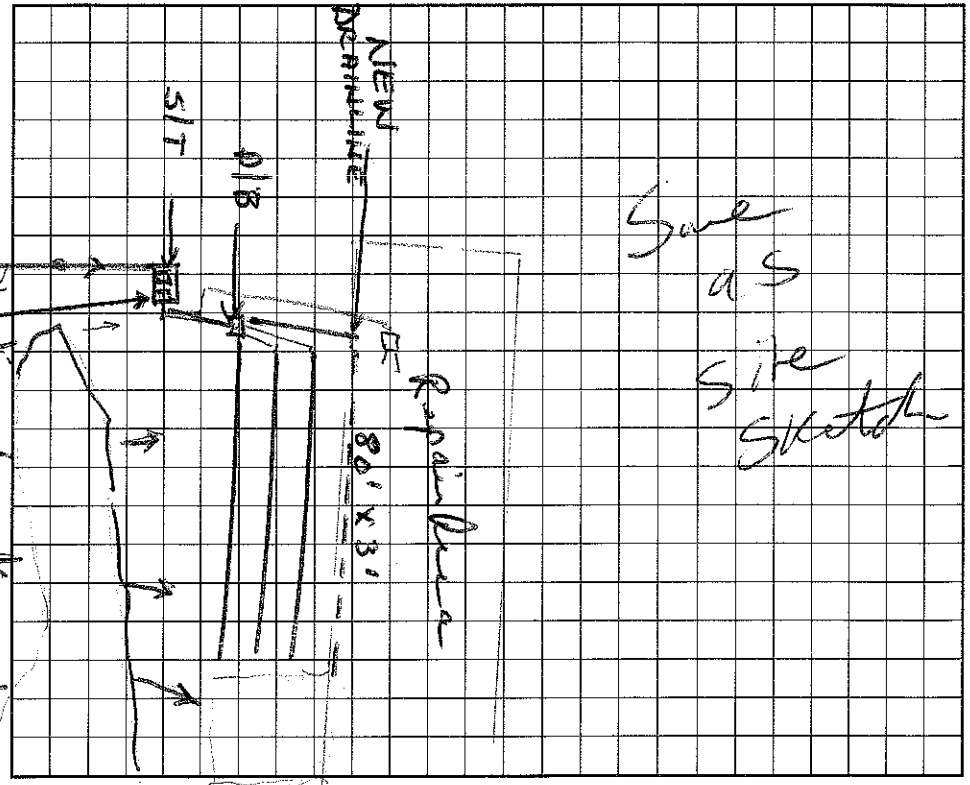

I understand that this permit can be suspended or revoked if any false information is supplied toward securing the permit/any unauthorized changes are made to the site/any unauthorized changes are made in the installation of the system.

Signed: ~~John~~ Joan Chapman 915'

Improvement Permit by: Wesley Sparks RS date 10/31/96

Existing System Inspection by: Wesley Sparks RS. date 10/31/96

Installed by: WAYNE CONTZ

Certificate of Completion by: ____ date ____

Operation Permit by: [signature] date 10/30/97

HEALTH DEPT. COPY: WHITE INSPECTION COPY (FINAL): GREEN OWNER COPY (FINAL): YELLOW INSPECTION COPY (INITIAL): PINK OWNER COPY (INITIAL): GOLD