IREDELL COUNTY HEALTH DEPARTMENT

STATESVILLE 704-878-5305 MOORESVILLE 704-664-5281

IMPROVEMENT PERMIT / AUTHORIZATION TO CONSTRUCT / OPERATION PERMIT / EXISTING SYSTEM INSPECTION

PERMIT# 076080 PIN# 4677708213

OWNER OR CONTRACTOR DAVID BRACKETT PHONE: Business _____ Home 786-1367 DATE 9/22/98

ADDRESS 5275 ALBROOK DR. DAVIDSON NC 28036

LOCATION LINWOOD - TL TEETER - 1.5 MILES ON LT. ACROSS FROM #299

SUBDIVISION — BLOCK / SECTION — LOT — LOT AREA 7.10AC SITE CLASS. PS DESIGN FLOW 360 L.T.A.R. .30 APPT

Septic Tank: 1000 Gallons; STB 794 Date _____

Pump Tank: _____ Gallons; PT _____ Date _____

Pump Make: _____ Model _____ Serial No. _____

Nitrification Field: No Fields 1 Square Feet 900 Linear Feet 300

No Lines 3 @ 100' Trench Width 36" Max Trench Bottom Depth 36" Gravel Depth N/A

☑ New System ☐ Repair System Type: I, II, III, IV, V, VI

System Description: GRAVITY CHAMBERS OR NDS

Repair System Description: PANEL

Maintenance Agreement Required: ☐ Yes ☑ No

☑ House/Mod. Home No. Bedrooms 3

☐ Mobile Home No. Bathrooms 2

☐ Business No. Employees ___

☐ Other _____


☐ Slab ☑ Crawl Space ☐ Basement w/plumbing ☐ Basement wo/plumbing

Water Supply: ☑ Individual ☐ Public ☐ Community

Comments:/Conditions:

Comments:/Conditions:

INITIAL SITE SKETCH NOT TO SCALE

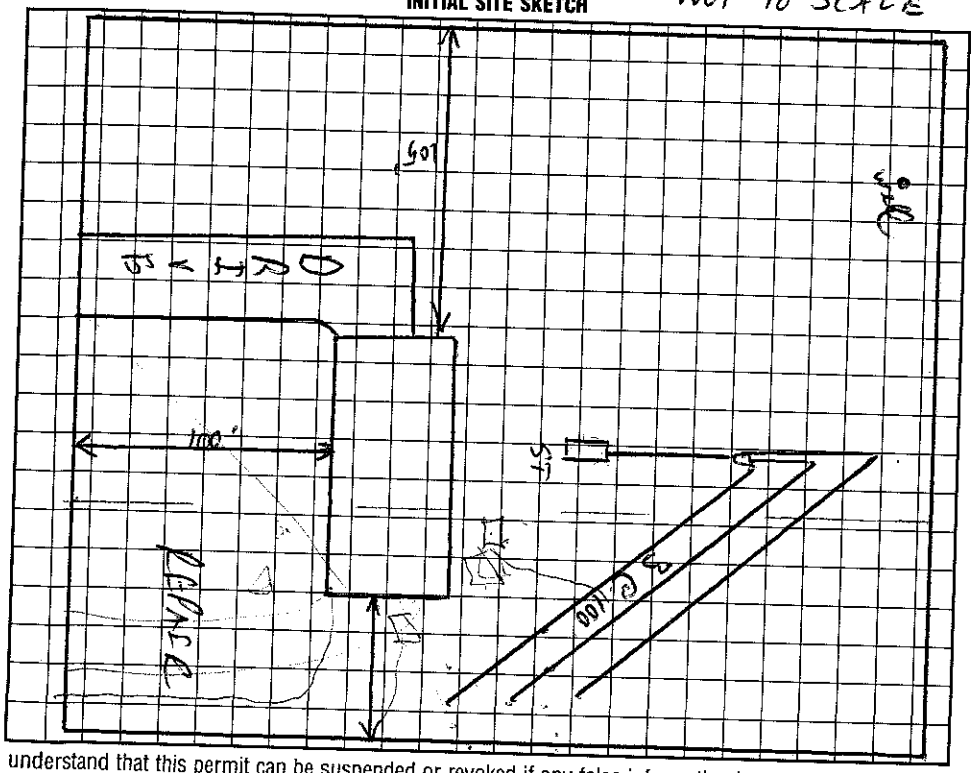

AS BUILT SKETCH

I understand that this permit can be suspended or revoked if any false information is supplied toward securing the permit/any unauthorized changes are made to the site/any unauthorized changes are made in the installation of the system. Improvement Permit with plat valid without expiration. Improvement Permit with site plan valid for sixty months. Authorization to Construct is valid for a period equal to that of Improvement Permit – not to exceed sixty months.

Signed: Sylvia Brackett date 9/23/98

Improvement Permit by: C. M. Freeman RS date 9/22/98

Authorization to Construct by: C. M. Freeman RS date 9/22/98

Installed by: Larry Tucker

Operation Permit by: Wesley Sparks RS date 11/9/98

Existing System Inspection by: _____ date _____

HEALTH DEPT. COPY: WHITE INSPECTION COPY (FINAL): GREEN OWNER COPY (FINAL): YELLOW INSPECTION COPY (INITIAL): PINK OWNER COPY (INITIAL): GOLD