IREDELL COUNTY HEALTH DEPARTMENT

STATESVILLE 704-878-5305 MOORESVILLE 704-664-5281

4677751807

IMPROVEMENT PERMIT / CERTIFICATE OF COMPLETION / OPERATION PERMIT / EXISTING SYSTEM INSPECTION

PROPERTY DESCRIPTION NO. Repair DATE 3/5/96 TAX MAP NO. Watershed: ☐ Yes ☐ No

OWNER OR CONTRACTOR Bill Hart PHONE: Business Home 664-5037

ADDRESS 1947 Landis Hwy Mooresville 28115

LOCATION 152 East - ½ mile past 150 Jct. on 152 East 3rd house on left

SUBDIVISION BLOCK / SECTION LOT LOT AREA SITE CLASS. PS DESIGN FLOW 360 L.T.A.R. .3 spe/ftg =

Septic Tank: 1000 Gallons; STB Date

Pump Tank: Gallons; PT Date

Pump Make: Model Serial No.

Nitrification Field: No Fields 1 Square Feet 900 Linear Feet 300

No Lines 4 Trench Width 36" Max Trench Bottom Depth 36" Gravel Depth n/a

☐ New System ☑ Repair System Type: I, II, III, IV, V, VI

System Description: Gravity Infiltrator

Repair System Description:

Maintenance Agreement Required: ☐ Yes ☑ No

☑ House/Mod. Home No. Bedrooms 3

☐ Mobile Home No. Bathrooms 2

☐ Business No. Employees

☐ Other


☐ Slab ☑ Crawl Space ☐ Basement w/plumbing ☐ Basement wo/plumbing

Water Supply: ☑ Individual ☐ Community ☐ Public


Comments:

Comments:

INITIAL SITE SKETCH

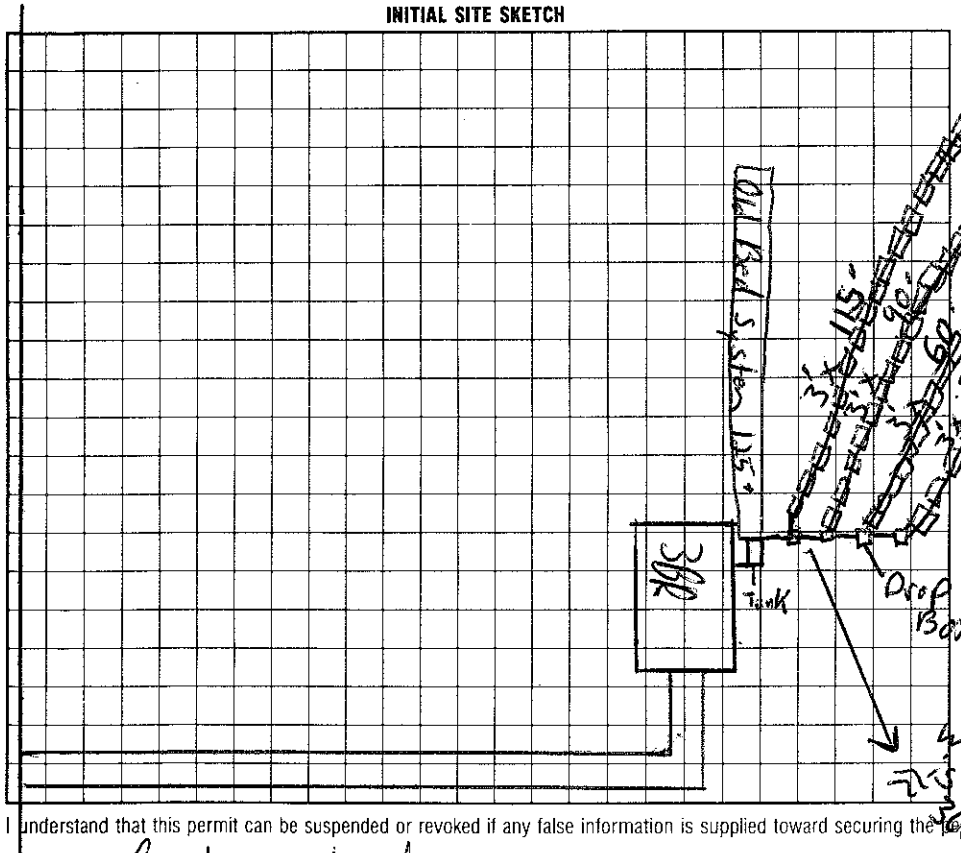

AS BUILT SKETCH

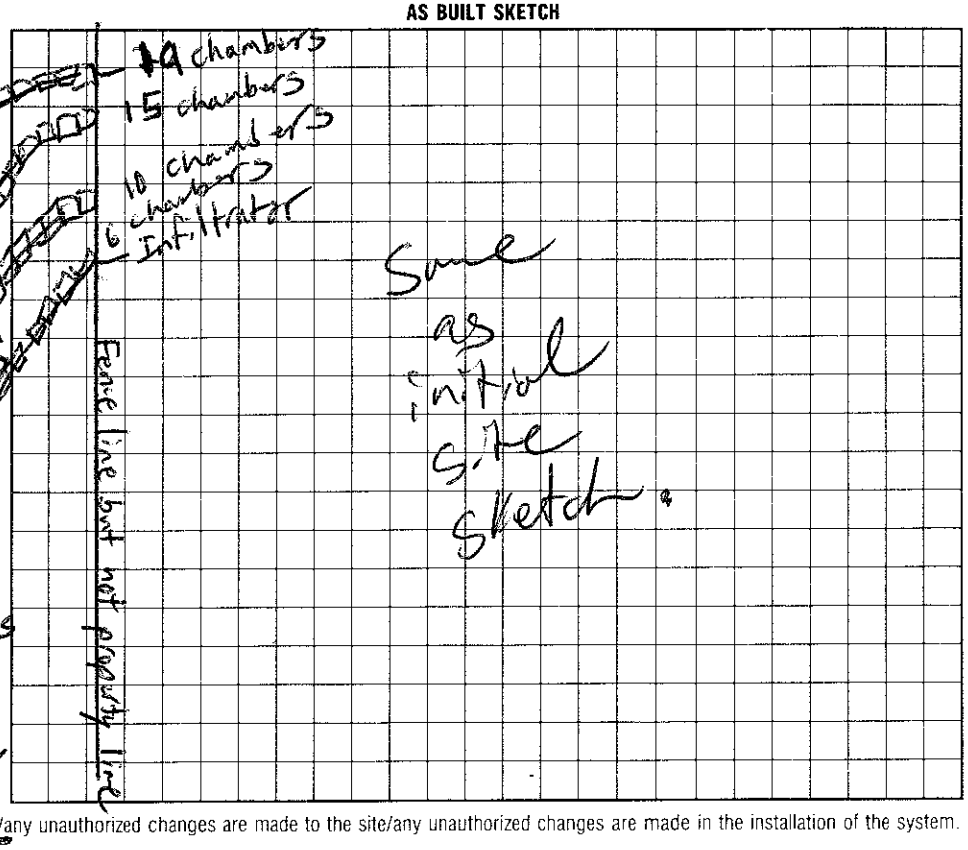

I understand that this permit can be suspended or revoked if any false information is supplied toward securing the permit/any unauthorized changes are made to the site/any unauthorized changes are made in the installation of the system.

Signed X Becky Hart Installed by: FJ Ervin

Improvement Permit by: date

Existing System Inspection by: C. Bridgeman BHSI date 3/6/96

Certificate of Completion by: date

Operation Permit by: C. Bridgeman EHSI date 5/6/96


HEALTH DEPT. COPY: WHITE INSPECTION COPY (FINAL): GREEN OWNER COPY (FINAL): YELLOW INSPECTION COPY (INITIAL): PINK OWNER COPY (INITIAL): GOLD