# IREDELL COUNTY HEALTH DEPARTMENT

Authorization to Construct

4677793951

STATESVILLE 704-878-5305 MOORESVILLE 704-664-5281

## IMPROVEMENT PERMIT / ~~CERTIFICATE OF COMPLETION~~ / OPERATION PERMIT / EXISTING SYSTEM INSPECTIO

PROPERTY DESCRIPTION NO. 23411 DATE 4/30/96 TAX MAP NO. 1P-1-A-20 pt of Watershed: ☑ Yes ☐ No

OWNER OR CONTRACTOR Tim Wensil PHONE: Business Home 663-1789

ADDRESS PO Box 851 Mooresville NC 28115

LOCATION 150 E - TL Pineridge Dr. 1/4 mile on left - 250' off of Rd

SUBDIVISION TL Wensil BLOCK / SECTION LOT 202 LOT AREA 1.135 ac SITE CLASS PS DESIGN FLOW 480 gpd L.T.A.R. .3 gpd/sf

Septic Tank: 1000 Gallons; STB 331 Date 4/25/96

Pump Tank: Gallons; PT Date

Pump Make: Model Serial No.

Nitrification Field: No Fields 1 Square Feet 1600 Linear Feet 533

No Lines 4 Trench Width 36" Max Trench Bottom Depth 24" Gravel Depth 12"

☑ New System ☐ Repair System Type: I (II) III, IV, V, VI

System Description: Gravity Conventional

Repair System Description: Gravity Chambered

Maintenance Agreement Required: ☐ Yes ☑ No

☐ House/Mod. Home No. Bedrooms 4

☑ Mobile Home No. Bathrooms 2

☐ Business No. Employees

☐ Other


☐ Slab ☑ Crawl Space ☐ Basement w/plumbing ☐ Basement wo/plumbing

Water Supply: ☑ Individual ☐ Community ☐ Public


Comments: System may be fed from ends with Distribution box.

Comments:

**INITIAL SITE SKETCH**

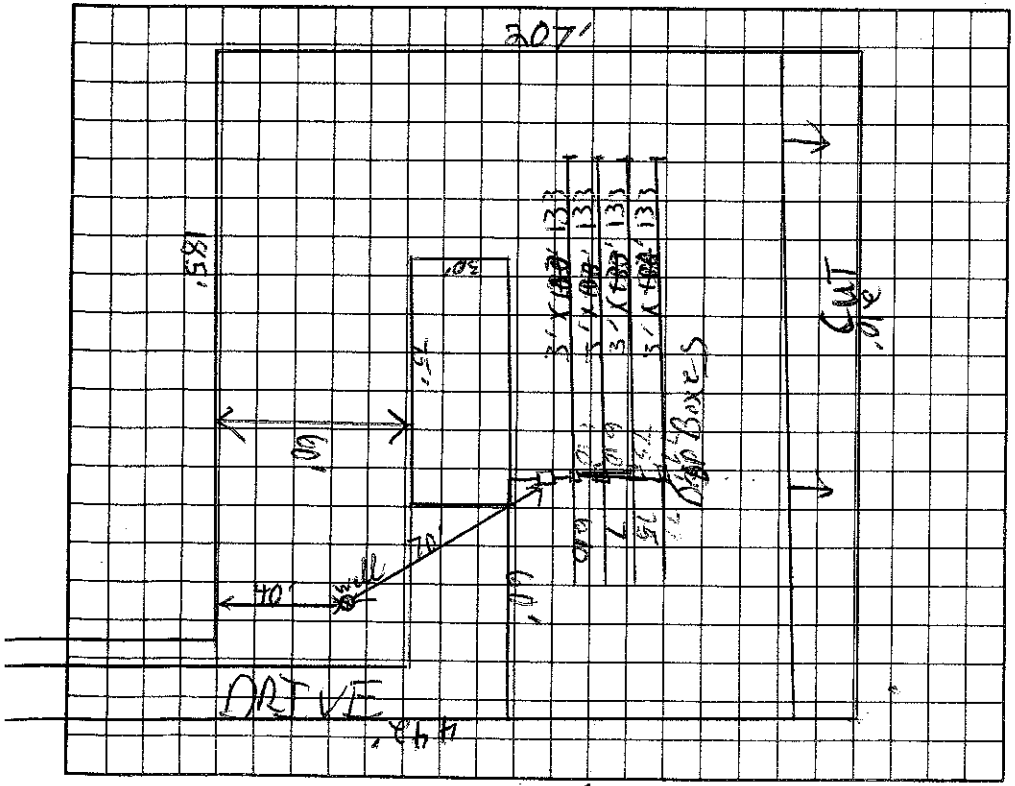


**AS BUILT SKETCH**

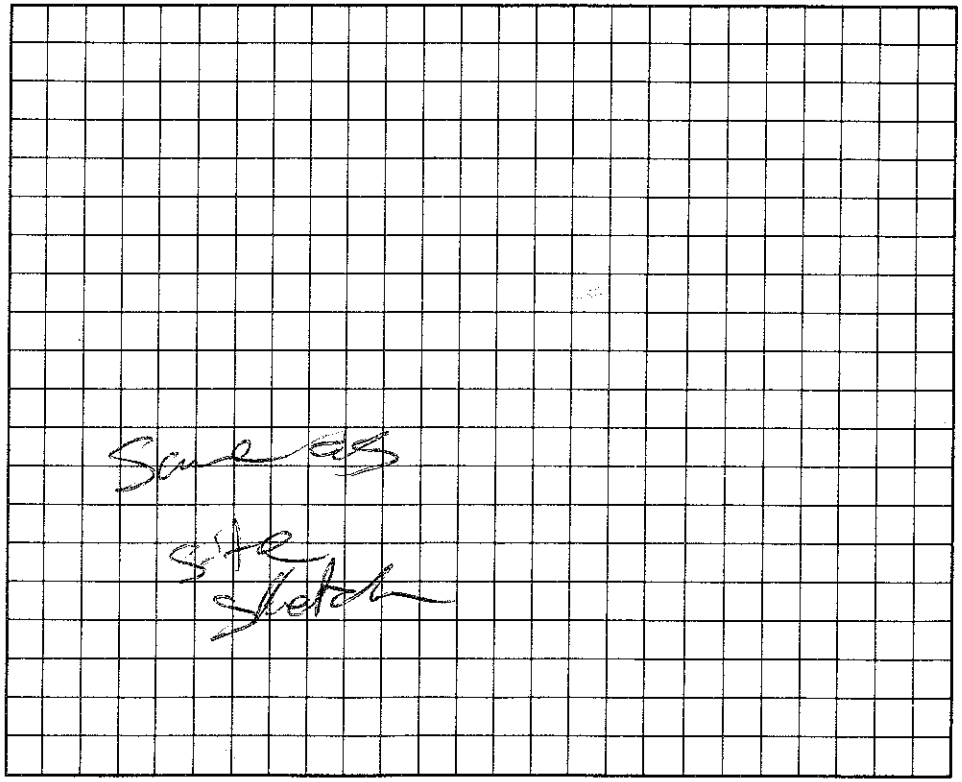


I understand that this permit can be suspended or revoked if any false information is supplied toward securing the permit/any unauthorized changes are made to the site/any unauthorized changes are made in the installation of the system.

Signed: Tim J. Wensil Installed by: C & M Enterprises

Improvement Permit by: C. Brad Jones EHSI date 4/30/96

Authorization to Construct

~~Existing System Inspection by:~~ C. Brad Jones EHSI date

Certificate of Completion by: date

Operation Permit by: C. Brad Jones date 5/13/96

HEALTH DEPT. COPY: WHITE INSPECTION COPY (FINAL): GREEN OWNER COPY (FINAL): YELLOW INSPECTION COPY (INITIAL): PINK OWNER COPY (INITIAL): GOLD

Authorization to Construct is valid for 60 months from issue date.