IREDELL COUNTY HEALTH DEPARTMENT

STATESVILLE 704-878-5305 130.00 Pg. 9 MOORESVILLE 704-664-5281

IMPROVEMENT PERMIT / AUTHORIZATION TO CONSTRUCT / OPERATION PERMIT / EXISTING SYSTEM INSPECTION

PERMIT# 121762 PIN# 4677-79-5968 4677795856 DATE 7/19/04

OWNER OR CONTRACTOR Eufemio Brenden PHONE: Business 704-662-3453 Home

ADDRESS 127 Pinnacle Dr. Mooresville, NC. 28115

LOCATION 150 E TL Pinnacle Dr TL Granados Ln. 2nd MH on (R)

SUBDIVISION NC BLOCK / SECTION LOT LOT AREA ~1 AC SITE CLASS PS DESIGN FLOW 360 L.T.A.R. .30

Septic Tank: 1060 Gallons; STB 620 Date 7/20/04
Pump Tank: Gallons; PT Date
Pump Make: Model Serial No.
Nitrification Field: No Fields 1 Square Feet 900 Linear Feet 300
No Lines 3@100 Trench Width 3 Max Trench Bottom Depth 30

[X] New System [ ] Repair System Type: I, II, III, IV, V, VI
System Description: ~~Conv~~ Type 3
Repair System Description: Pumping-Type 3
Maintenance Agreement Required: [ ] Yes [X] No


[ ] House/Mod. Home No. Bedrooms 3
[X] Mobile Home No. Bathrooms
[ ] Business No. Employees
[ ] Other
Gravel Depth NO [ ] Slab [X] Crawl Space [ ] Basement w/plumbing [ ] Basement wo/plumbing

Water Supply: [X] Individual [ ] Public [ ] Community
DAN-3

Comments:/Conditions: H2O will come from Fathers well on left side on Granados Ln.
Some grading done - varying amounts of gravel fill material spread on trenchfield area, Maximum 30" depth.

Comments:/Conditions:

INITIAL SITE SKETCH

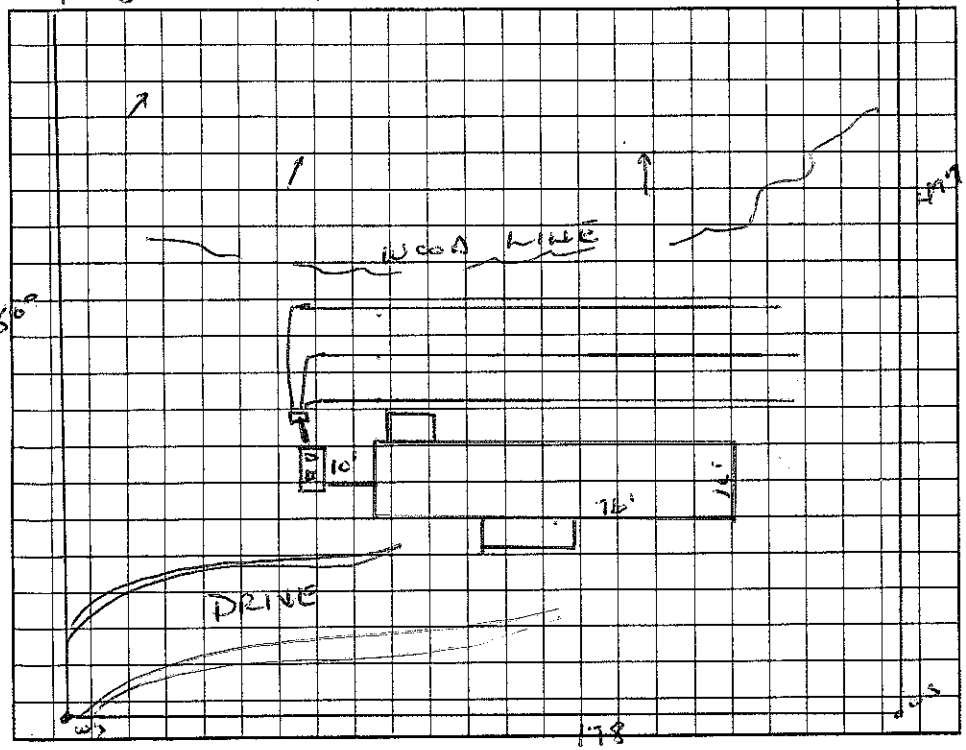

AS BUILT SKETCH

Permit can be suspended or revoked if any false information is supplied toward securing the permit/any unauthorized changes are made to the site/any unauthorized changes are made in the installation of the system. Improvement Permit with plat valid without expiration. Improvement Permit with site plan valid for sixty months. Authorization to Construct is valid for a period equal to that of Improvement Permit – not to exceed sixty months.

Signed: X Eufemio Brenden date 7-21-04
Improvement Permit by: Wesley Sparks R.S. date 7/19/04
Authorization to Construct by: Wesley Sparks R.S. date 7/19/04

Installed by: Sam Rowing Septic Tank
Operation Permit by: Wesley Sparks R.S. date 8/20/04
Existing System Inspection by: date

HEALTH DEPT. COPY: WHITE OWNER COPY (FINAL): YELLOW OWNER COPY (INITIAL): PINK