IREDELL COUNTY HEALTH DEPARTMENT

STATESVILLE 704-878-5305 MOORESVILLE 704-664-5281

IMPROVEMENT PERMIT / CERTIFICATE OF COMPLETION / OPERATION PERMIT / EXISTING SYSTEM INSPECTION

PROPERTY DESCRIPTION NO. 22352 DATE 1/3/96 TAX MAP NO. 1P 1A 22 Watershed: ☐ Yes ☒ No

OWNER OR CONTRACTOR Lambie Brandon PHONE: Business _____ Home 662-9430

ADDRESS 137 Brandon Ln. Mooresville, NC. 4677797582

LOCATION 150 E Tl Pine Ridge Rd, Tl frm, 1st drive to 1st Trailer on R

SUBDIVISION Mooresville Cont BLOCK / SECTION _____ LOT 22 LOT AREA 6A± SITE CLASS. _____ DESIGN FLOW 360 L.T.A.R. _____

Septic Tank: 2 @ 375 Gallons; STB _____ Date _____

Pump Tank: _____ Gallons; PT _____ Date _____

Pump Make: _____ Model _____ Serial No. _____

Nitrification Field: No Fields 2 Square Feet 750/750 Linear Feet 250/250

No Lines 3/2 Trench Width 36" Max Trench Bottom Depth _____ Gravel Depth _____

☐ New System ☐ Repair System Type: I, II, (III), IV, V, VI

System Description: Bed/Run - Conventional

Repair System Description: _____

Maintenance Agreement Required: ☐ Yes ☒ No

☐ House/Mod. Home No. Bedrooms 3

☒ Mobile Home No. Bathrooms 2

☐ Business No. Employees _____

☐ Other _____

☐ Slab ☒ Crawl Space ☐ Basement w/plumbing ☐ Basement wo/plumbing


Water Supply: ☒ Individual ☐ Community ☐ Public

Comments:

Comments: 11/3/96 BR Valve turned to send rainfall - had power been switched.

INITIAL SITE SKETCH

AS BUILT SKETCH

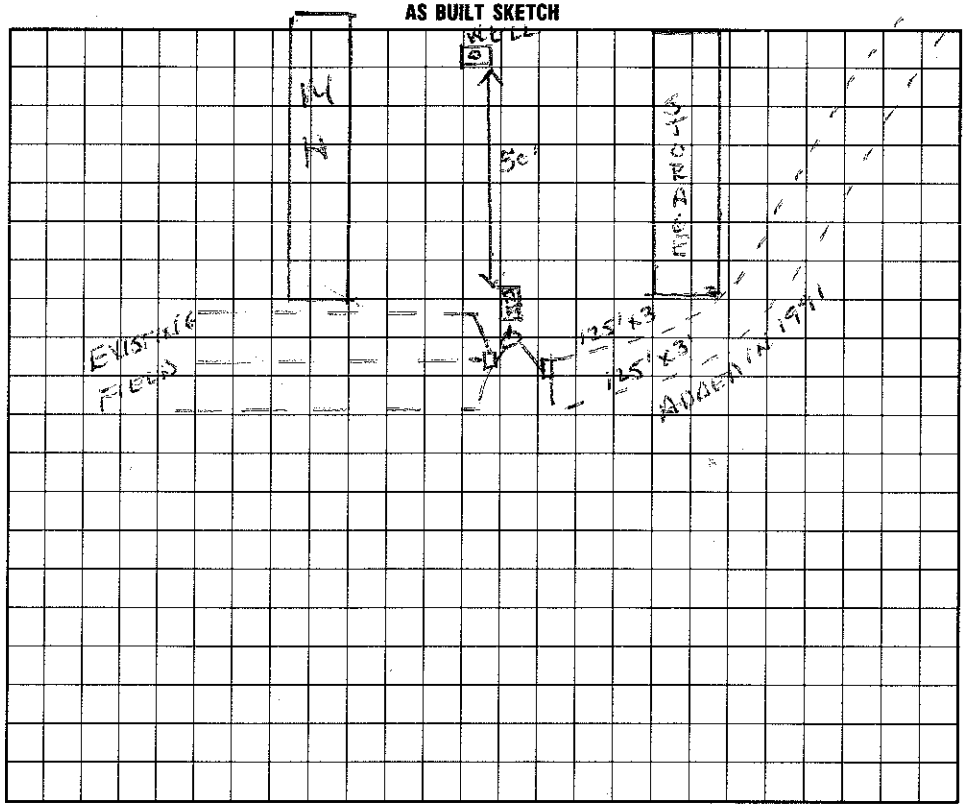

I understand that this permit can be suspended or revoked if any false information is supplied toward securing the permit/any unauthorized changes are made to the site/any unauthorized changes are made in the installation of the system.

Signed: _____

Improvement Permit by: _____ date _____

Existing System Inspection by: _____ date _____

Installed by: Danny Corrigan

Certificate of Completion by: Wesley Sparks RS date 1/3/96

Operation Permit by: Wesley Sparks RS. date 1/3/96

HEALTH DEPT. COPY: WHITE INSPECTION COPY (FINAL): GREEN OWNER COPY (FINAL): YELLOW INSPECTION COPY (INITIAL): PINK OWNER COPY (INITIAL): GOLD